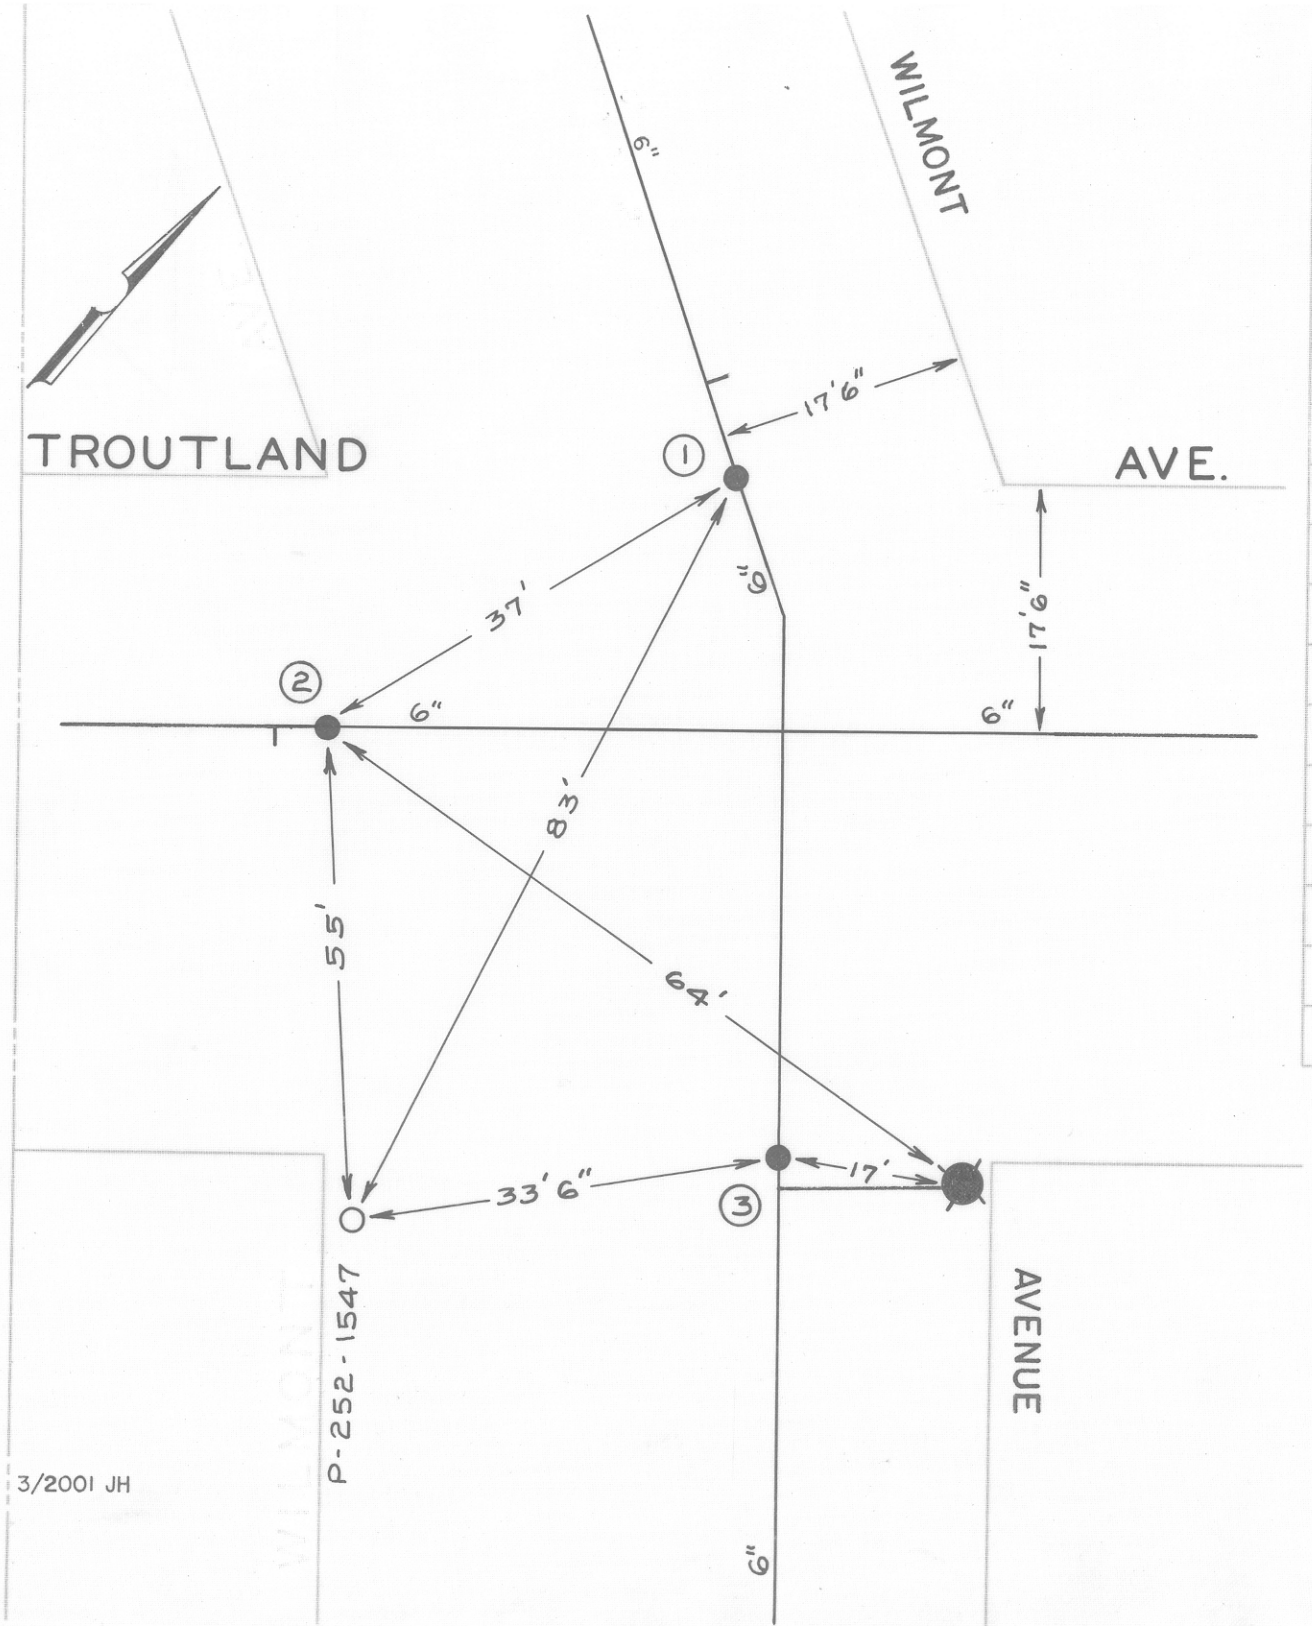

DATE	NO.	SIZE	MAKE	OPEN	TURNS
10-60	1	6"	MUE.	R	20
10-60	2	6"	MUE.	R	20
8-60	3	6"	MUE.	R	20
	1	0	NPL		
	2	0	WPL		
	3	0	SPL		

CITY OF ROANOKE—WATER DEP'T

VALVE DIAGRAM

TROUTLAND AVE. &
WILMONT AVE.

SEC. MAP 273 N.W.

DATE PAGE NO.

3/2001 JH