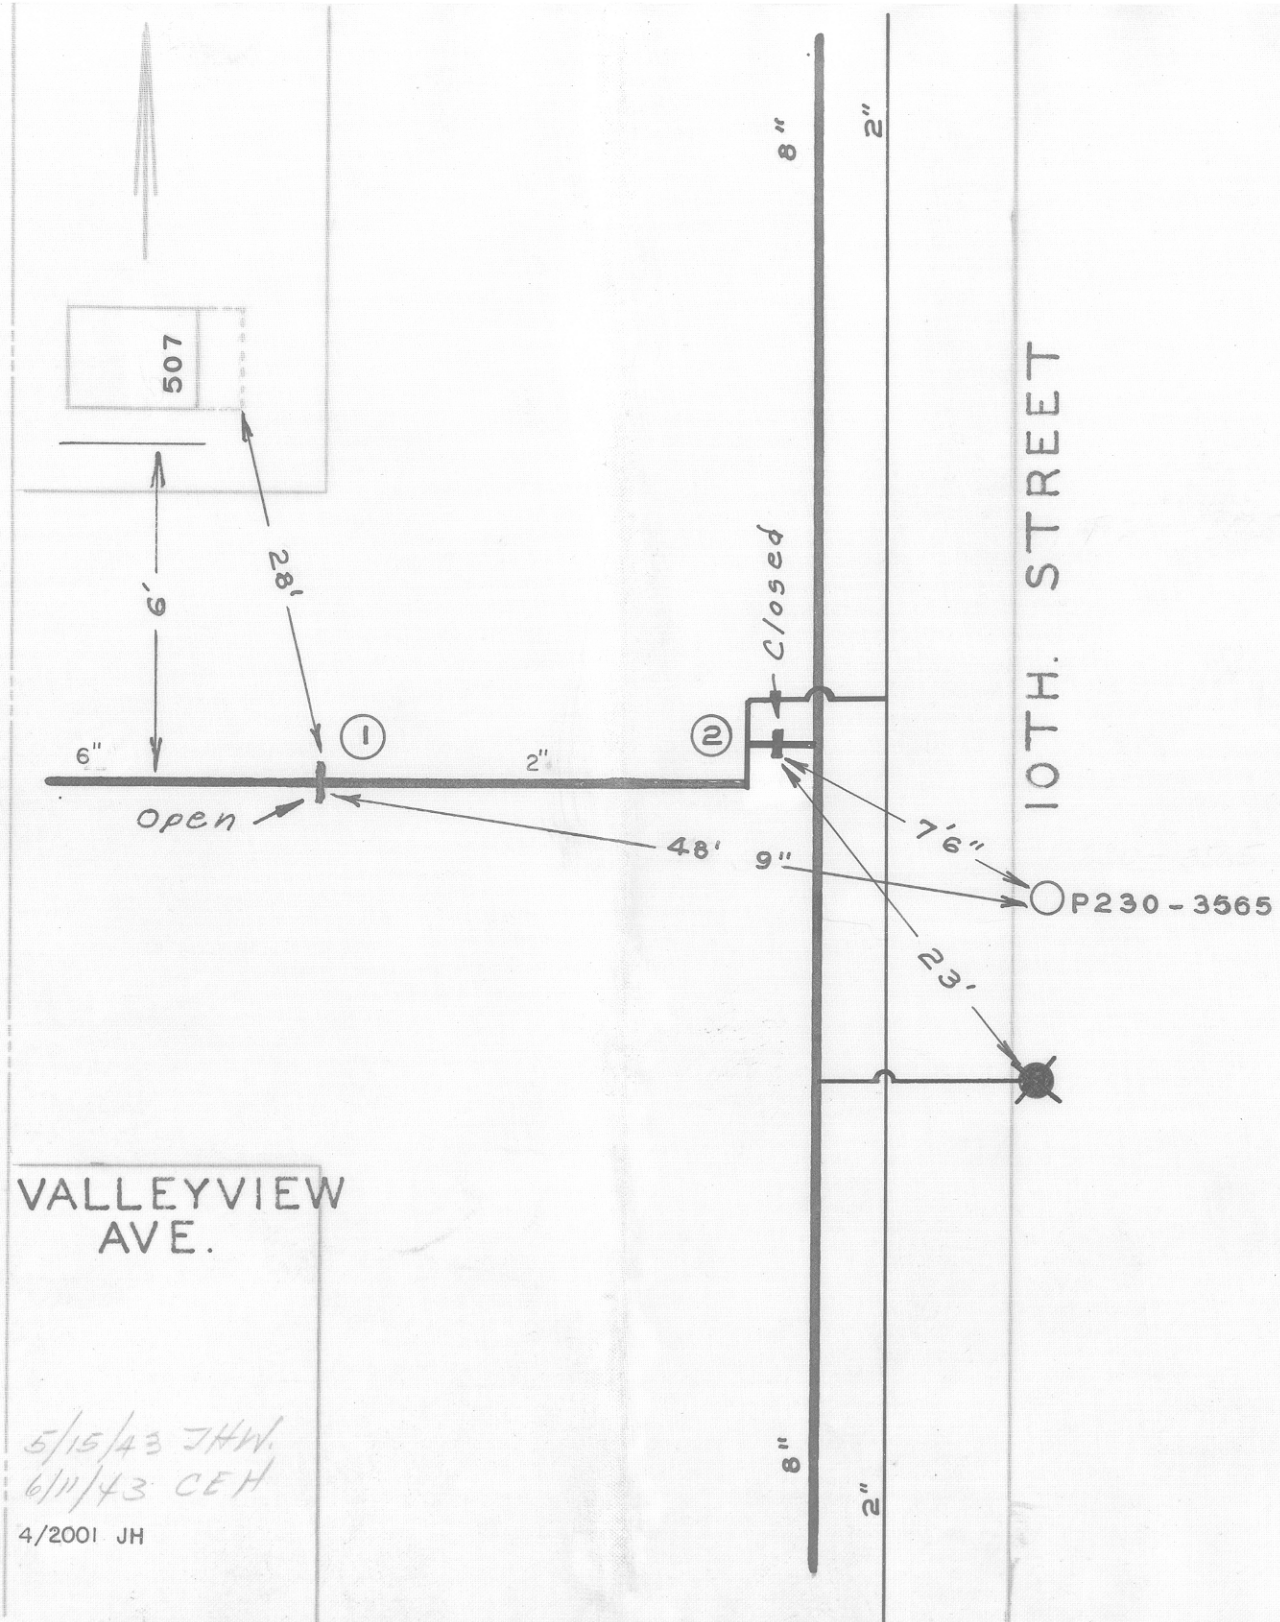

DATE	NO.	SIZE	MAKE	OPEN	TURNS
1931	1	2"		R	7 1/2
'58	2	2"			
	1	6'-W	WPL		

5/15/43 JHW.
6/11/43 CEH

4/2001 JH

CITY OF ROANOKE—WATER DEP'T
VALVE DIAGRAM

VALLEY VIEW AVE. &
10TH. STREET

SEC. MAP 214, 206 N.W.

DATE PAGE NO. NW-71