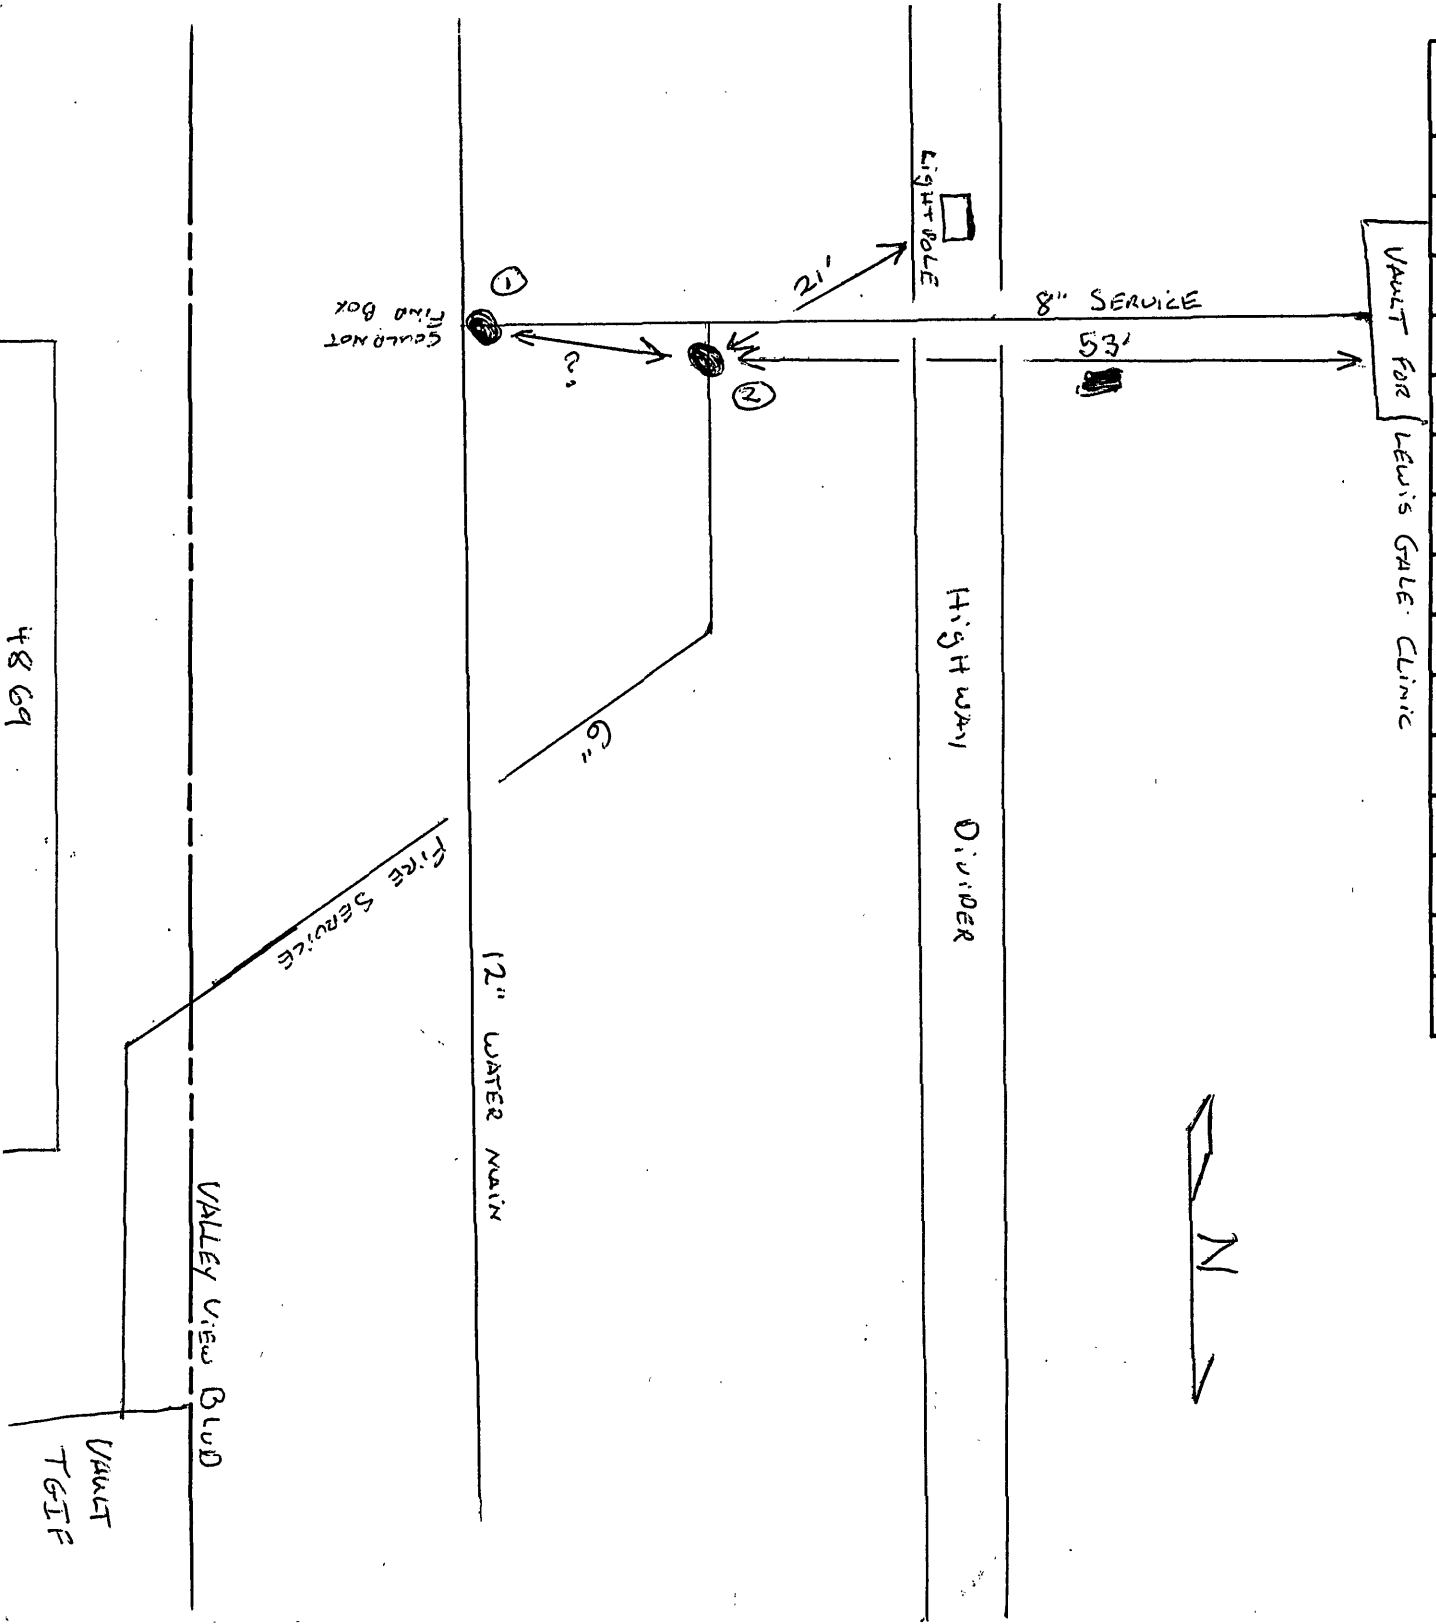

DATE	NO.	SIZE	MAKE	OPEN	TURNS
	1	8"		R	27
	2	6"	MULL.	R	21

CITY OF ROANOKE - WATER DEP'T.

VALVE DIAGRAM

4869 VALLEY VIEW BLVD. NW

"NORTH"

SEC. MAP 249

DATE: 1-29-01 PAGE NO.