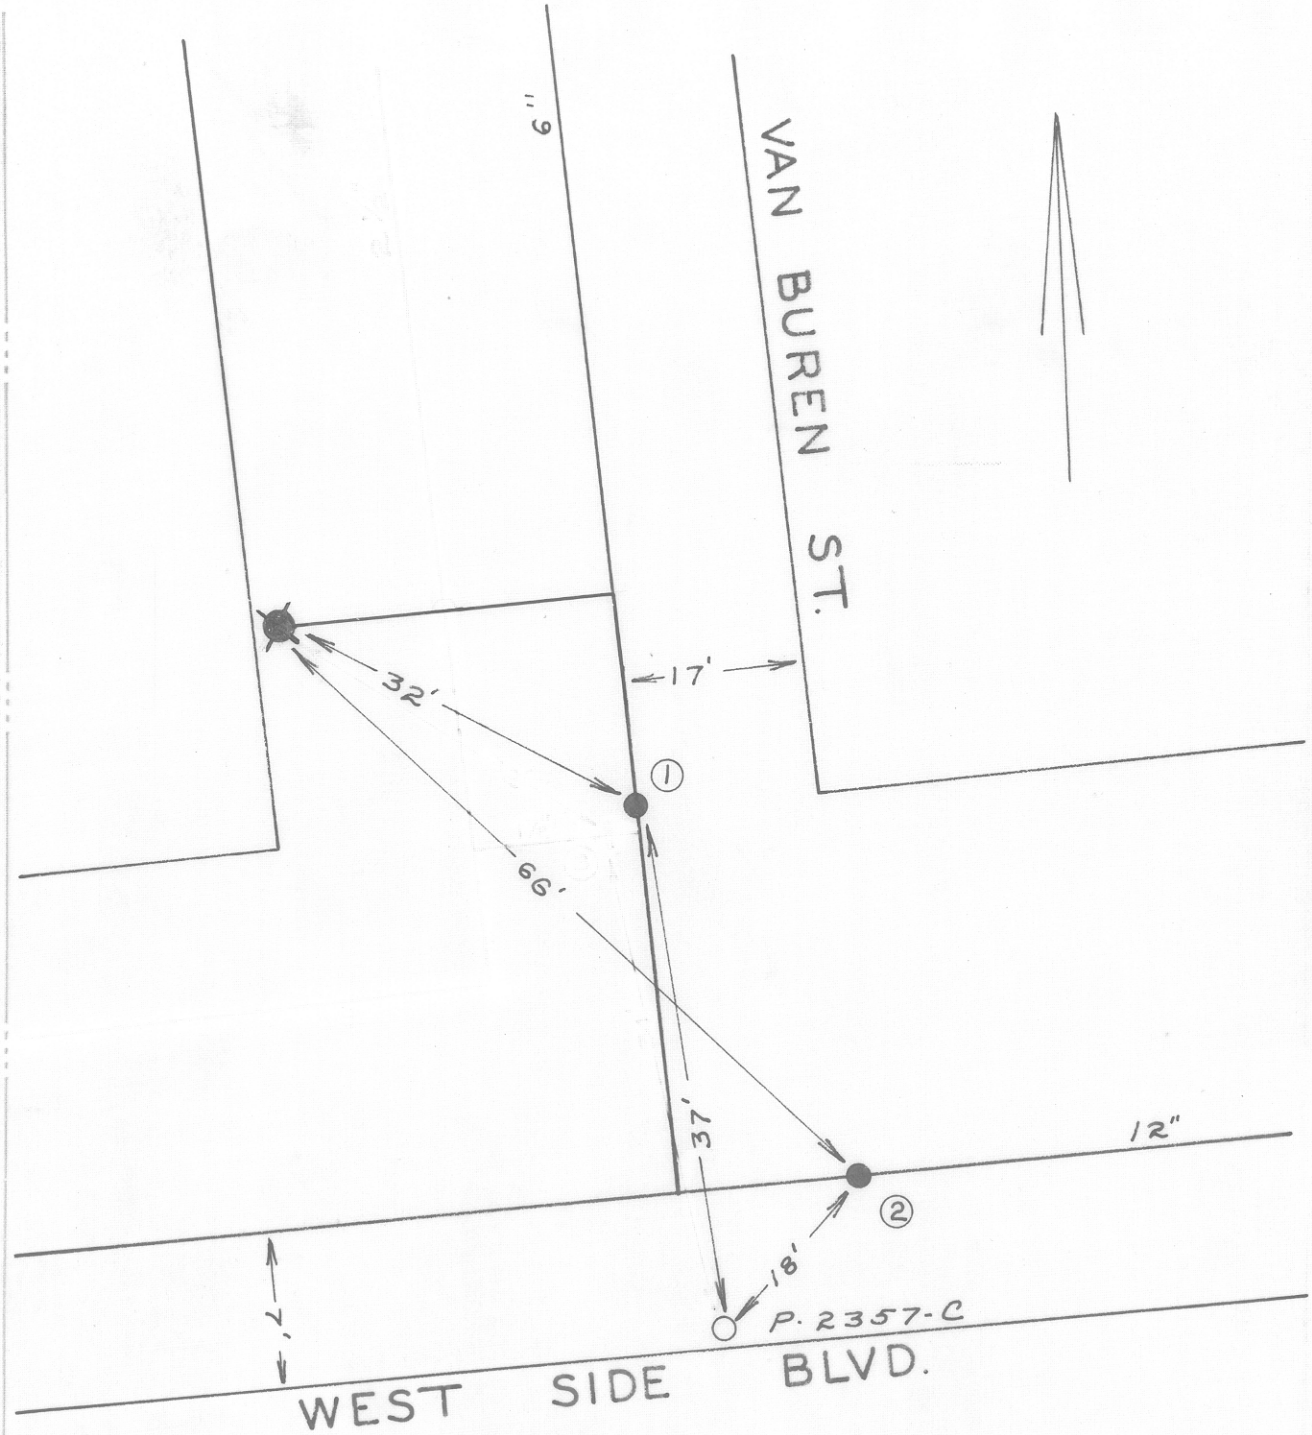

7/2000 JH

DATE	NO.	SIZE	MAKE	OPEN	TURNS
1952	1	6"	MUELLER	R	20
1952	2	12"	MUELLER	R	38
	1	0	NPL		
	2	0	EPL		

CITY OF ROANOKE — WATER DEPT.

VALVE DIAGRAM

VAN BUREN ST. &

WEST SIDE BLVD. N.W.

SEC. MAP 275

DATE PAGE NO.

"IMPERIAL" TRACING CLOTH. K & E CO., N.Y.