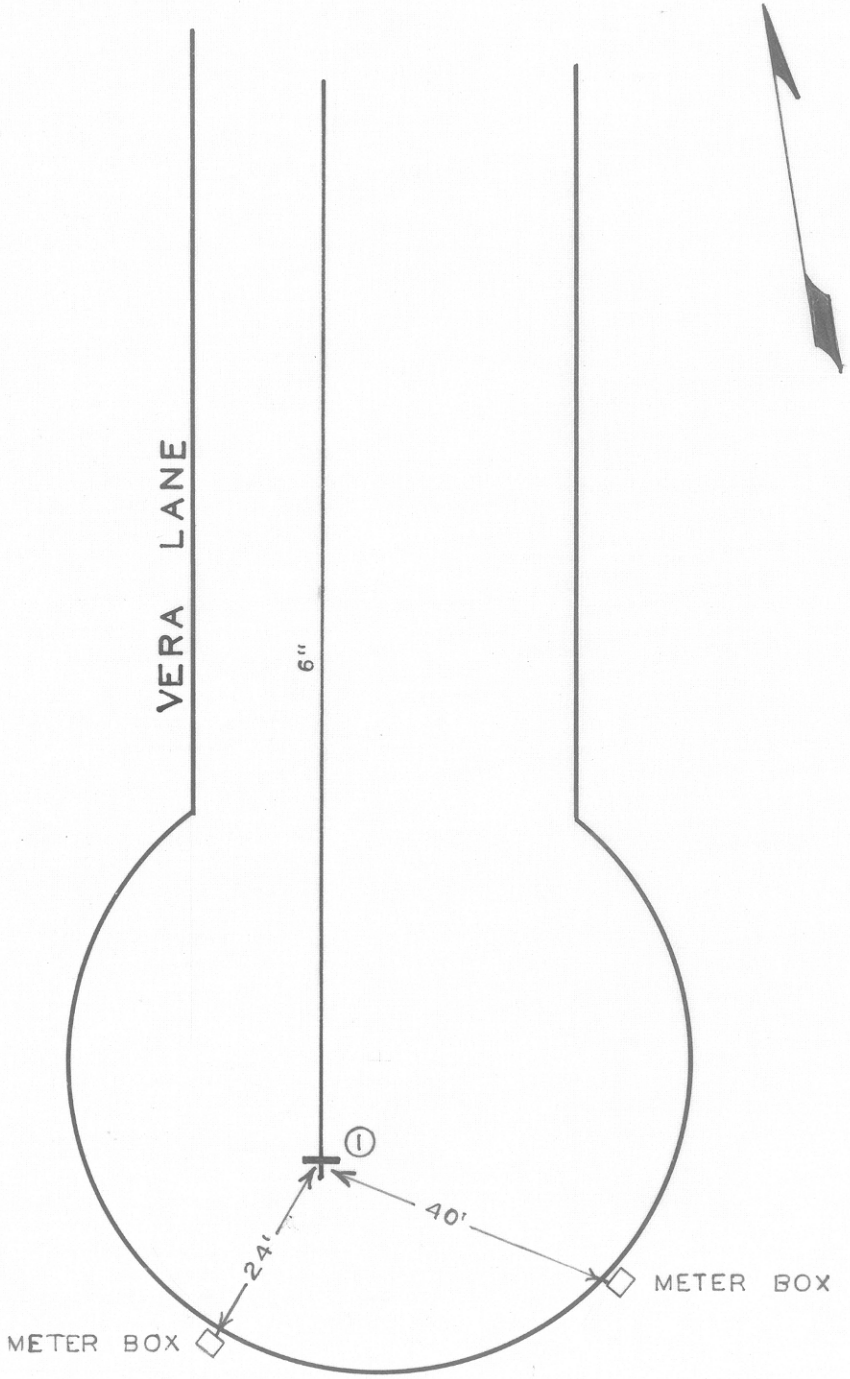

DATE	NO.	SIZE	MAKE	OPEN	TURNS
7-67	1	2	MISC.	BLOW	OFF

CITY OF ROANOKE—WATER DEPT.

VALVE DIAGRAM

VERA LANE N.W. 330'

SOUTH OF APPLETON AVE.

SEC. MAP 4

DATE PAGE NO.