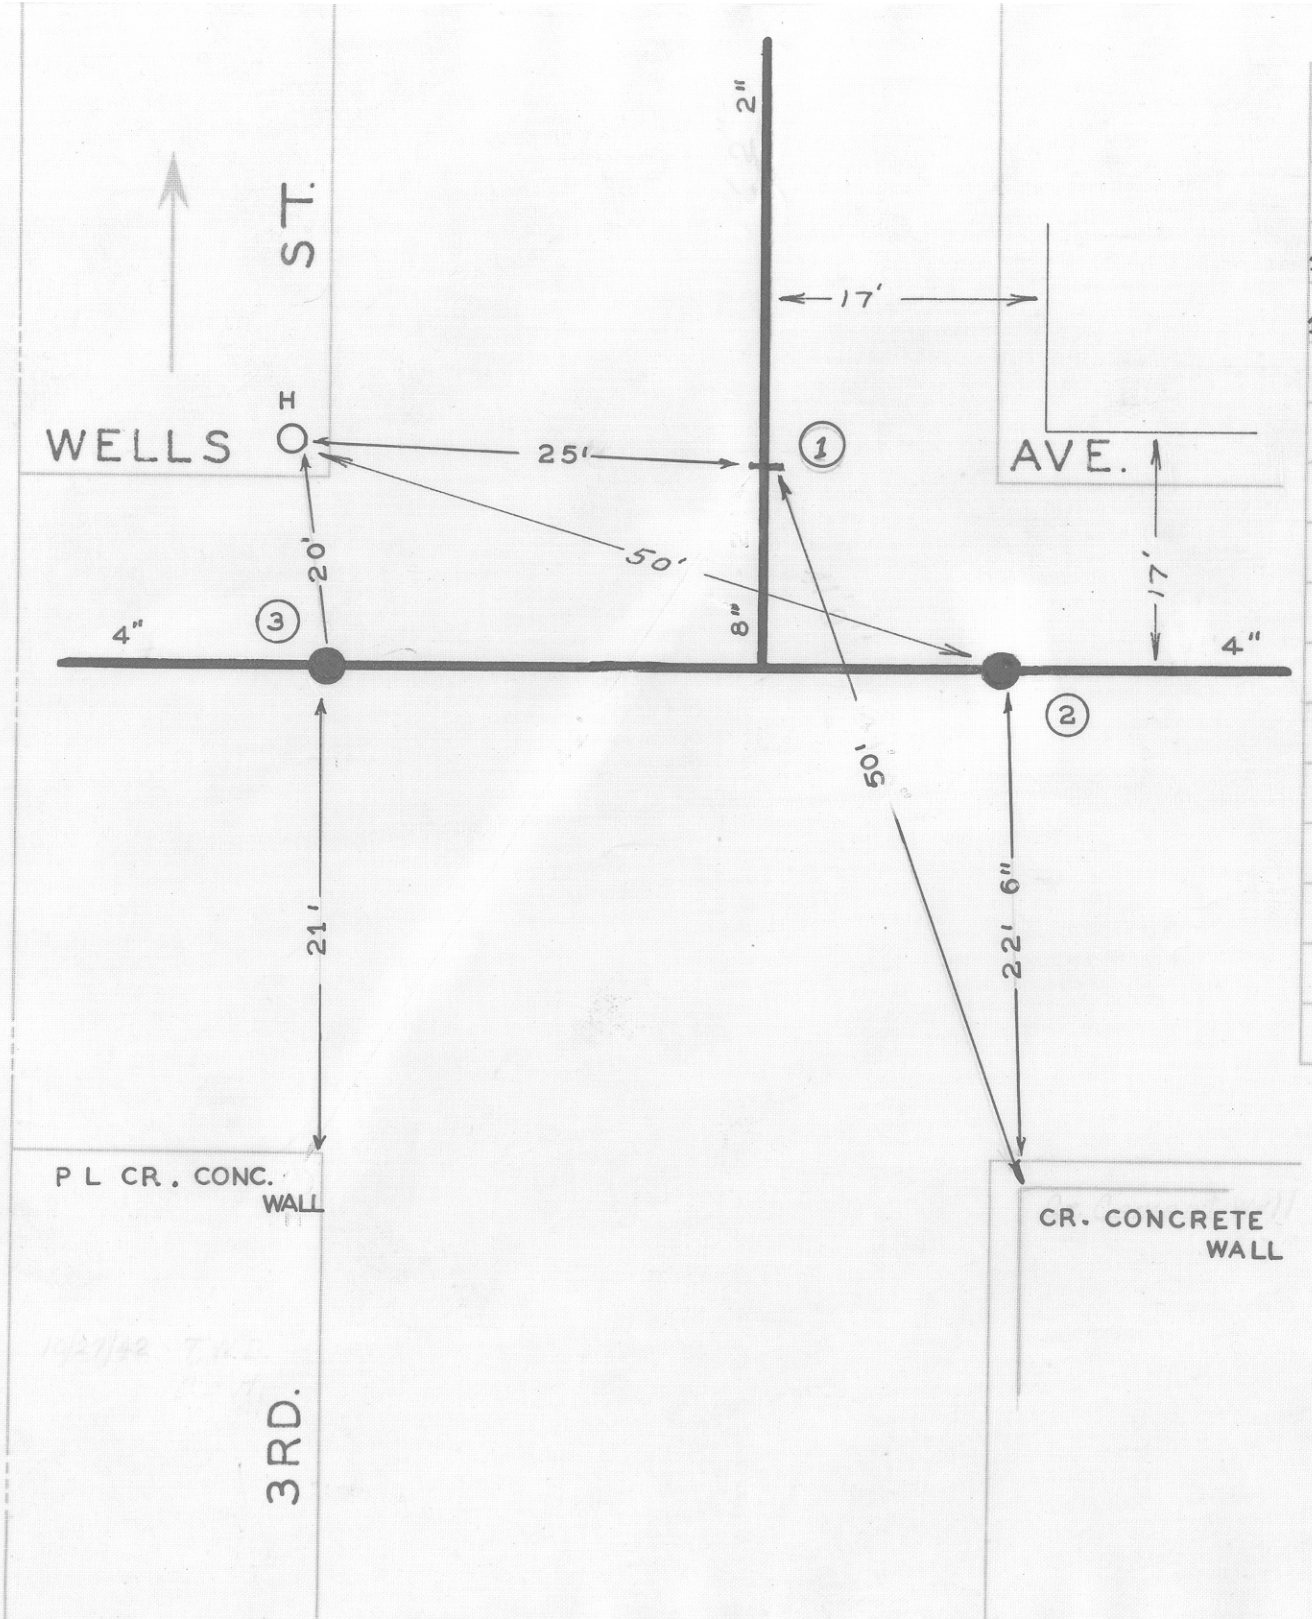

DATE	NO.	SIZE	MAKE	OPEN	TURNS
1927	1	2"		R	8
1946	2	4	DARLING	R	9
1946	3	4"	DARLING	R	9
	1	7'-N	N PL		
	2	7'-E	E PL		
	3	0	W PL		

CITY OF ROANOKE—WATER DEP'T

VALVE DIAGRAM

WELLS AVE. & 3RD. ST.

N. W.

SEC. MAP 201

DATE

PAGE NO. N.W. 15