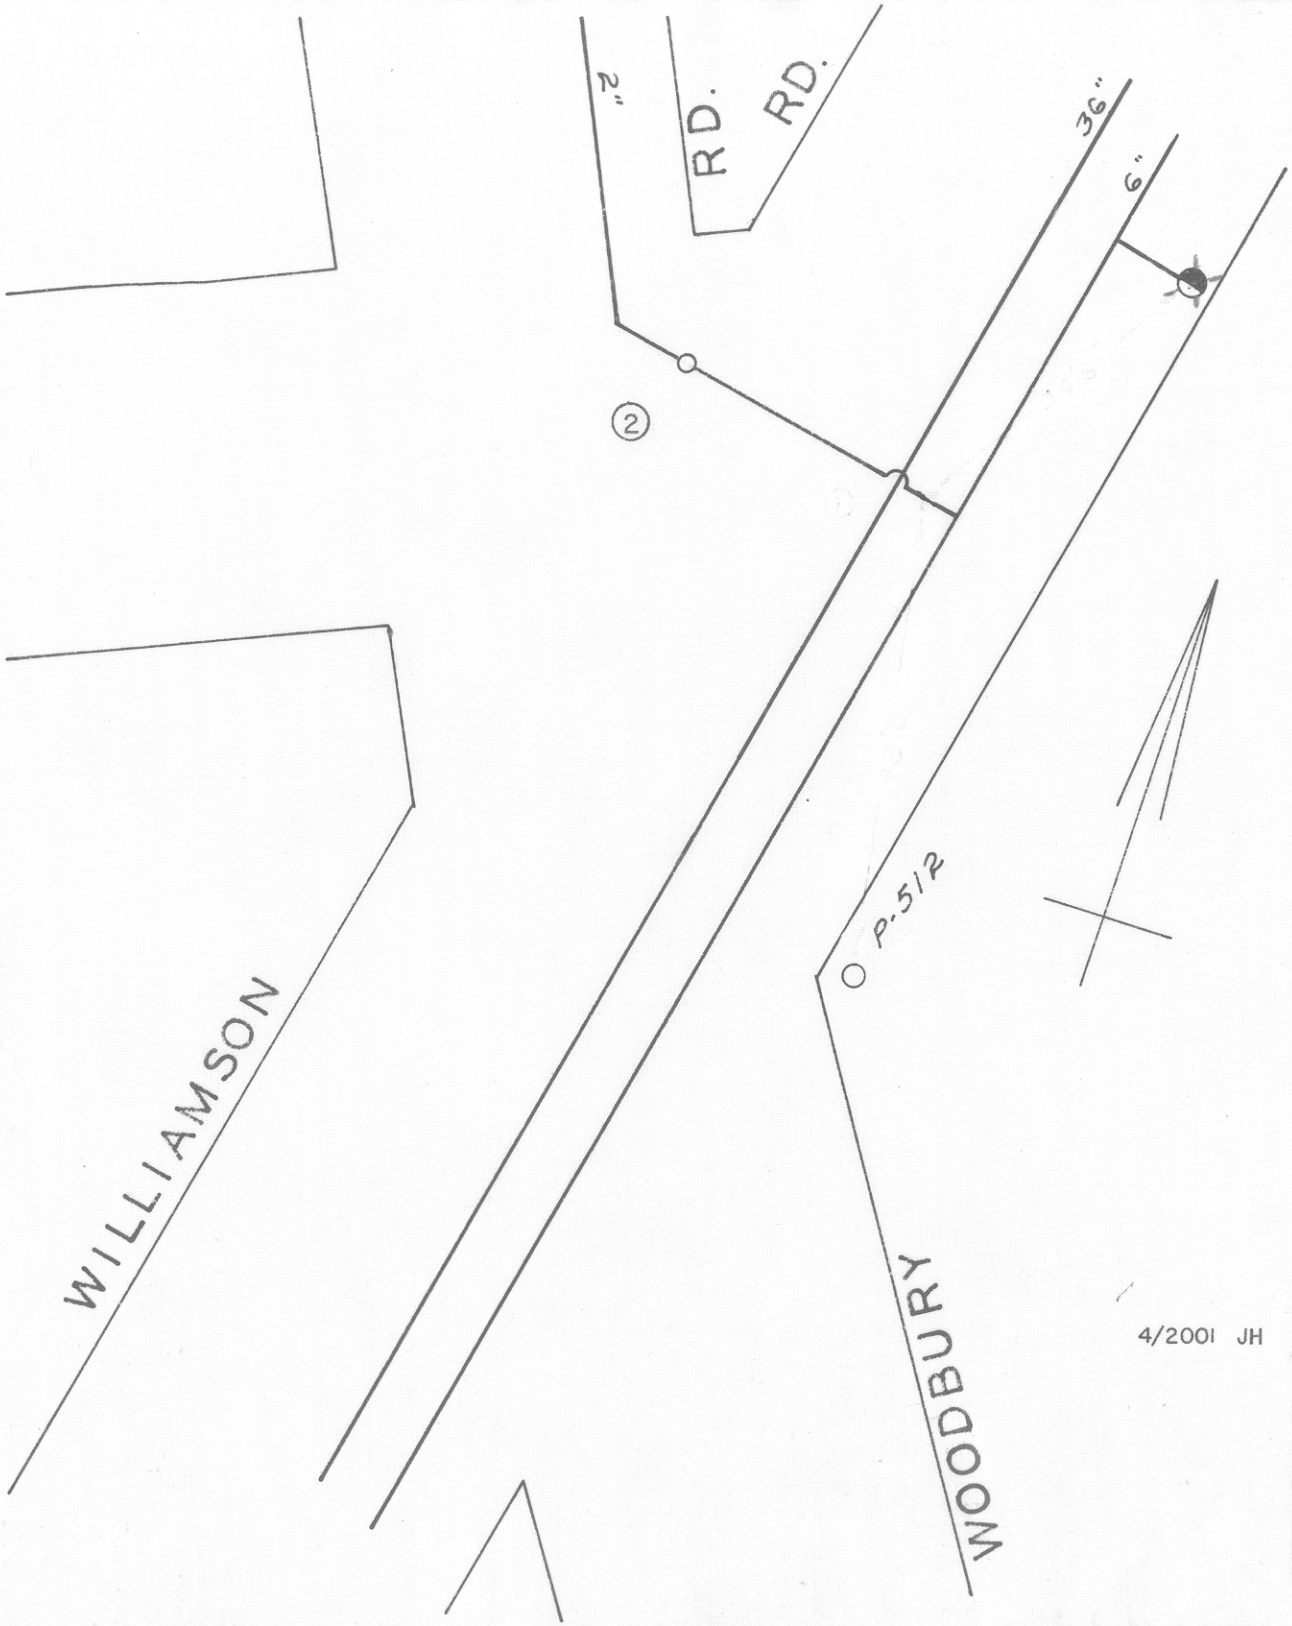

DATE	NO.	SIZE	MAKE	OPEN	TURNS
	~~1~~	~~2"~~			
1951	2	2"			
	1	36"-N NPL			
		52'-E WPL			

4/2001 JH

CITY OF ROANOKE—WATER DEPT.

VALVE DIAGRAM

WILLIAMSON RD. &

WOODBURY RD. N.W.

SEC. MAP 219

DATE PAGE NO.

"IMPERIAL" TRACING CLOTH. K&E CO., N.Y.