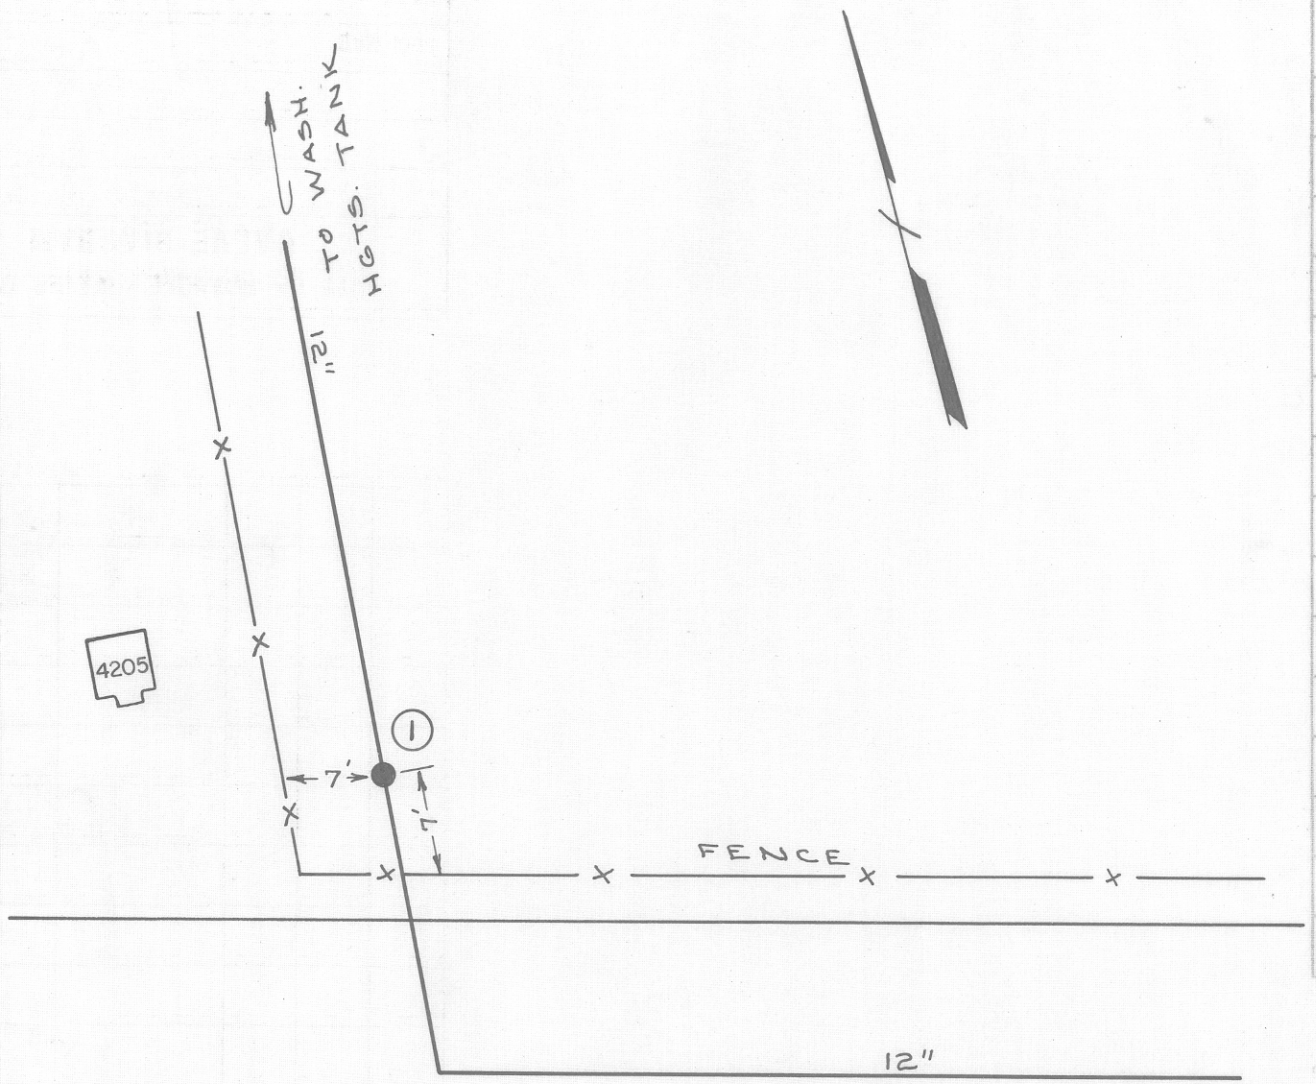

DATE	NO.	SIZE	MAKE	OPEN	TURNS
'60	1	12"	MUE.	R	

WYOMING AVENUE

4144

4/2001 JH

CITY OF ROANOKE—WATER DEPT.

VALVE DIAGRAM

WYOMING AVE. N.W.

NEAR WASH. HGTS.

TANK

SEC. MAP 277 N.W.

DATE PAGE NO.

"IMPERIAL" TRACING CLOTH. K & E CO., N. Y.