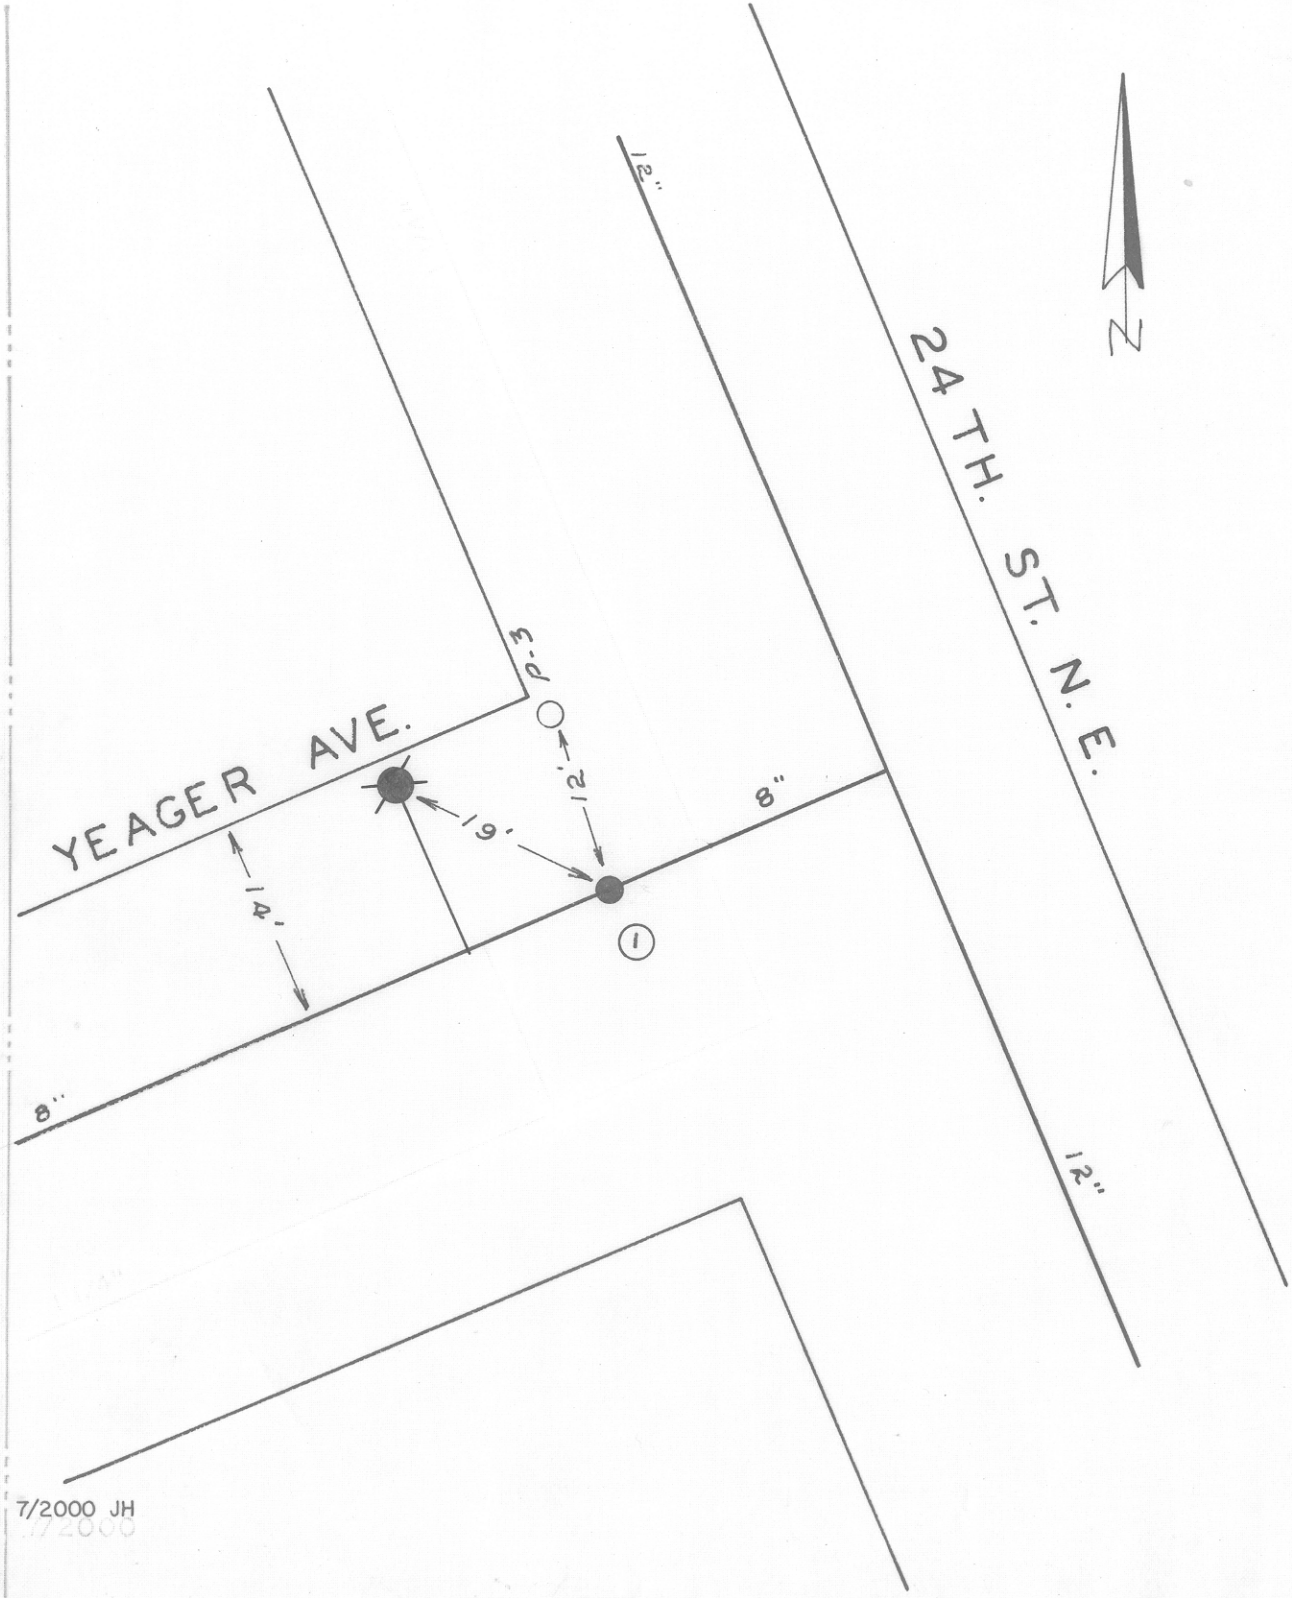

DATE	NO.	SIZE	MAKE	OPEN	TURNS
1953	1	8"	MUELLER	R	26
	1	0	WPL		

CITY OF ROANOKE—WATER DEPT.

VALVE DIAGRAM

YEAGER AVE. & 24TH. ST.

24 TH STREET

SEC. MAP 334 N.W.

DATE PAGE NO.

7/2000 JH

"IMPERIAL" TRACING CLOTH. K & E CO., N.Y.