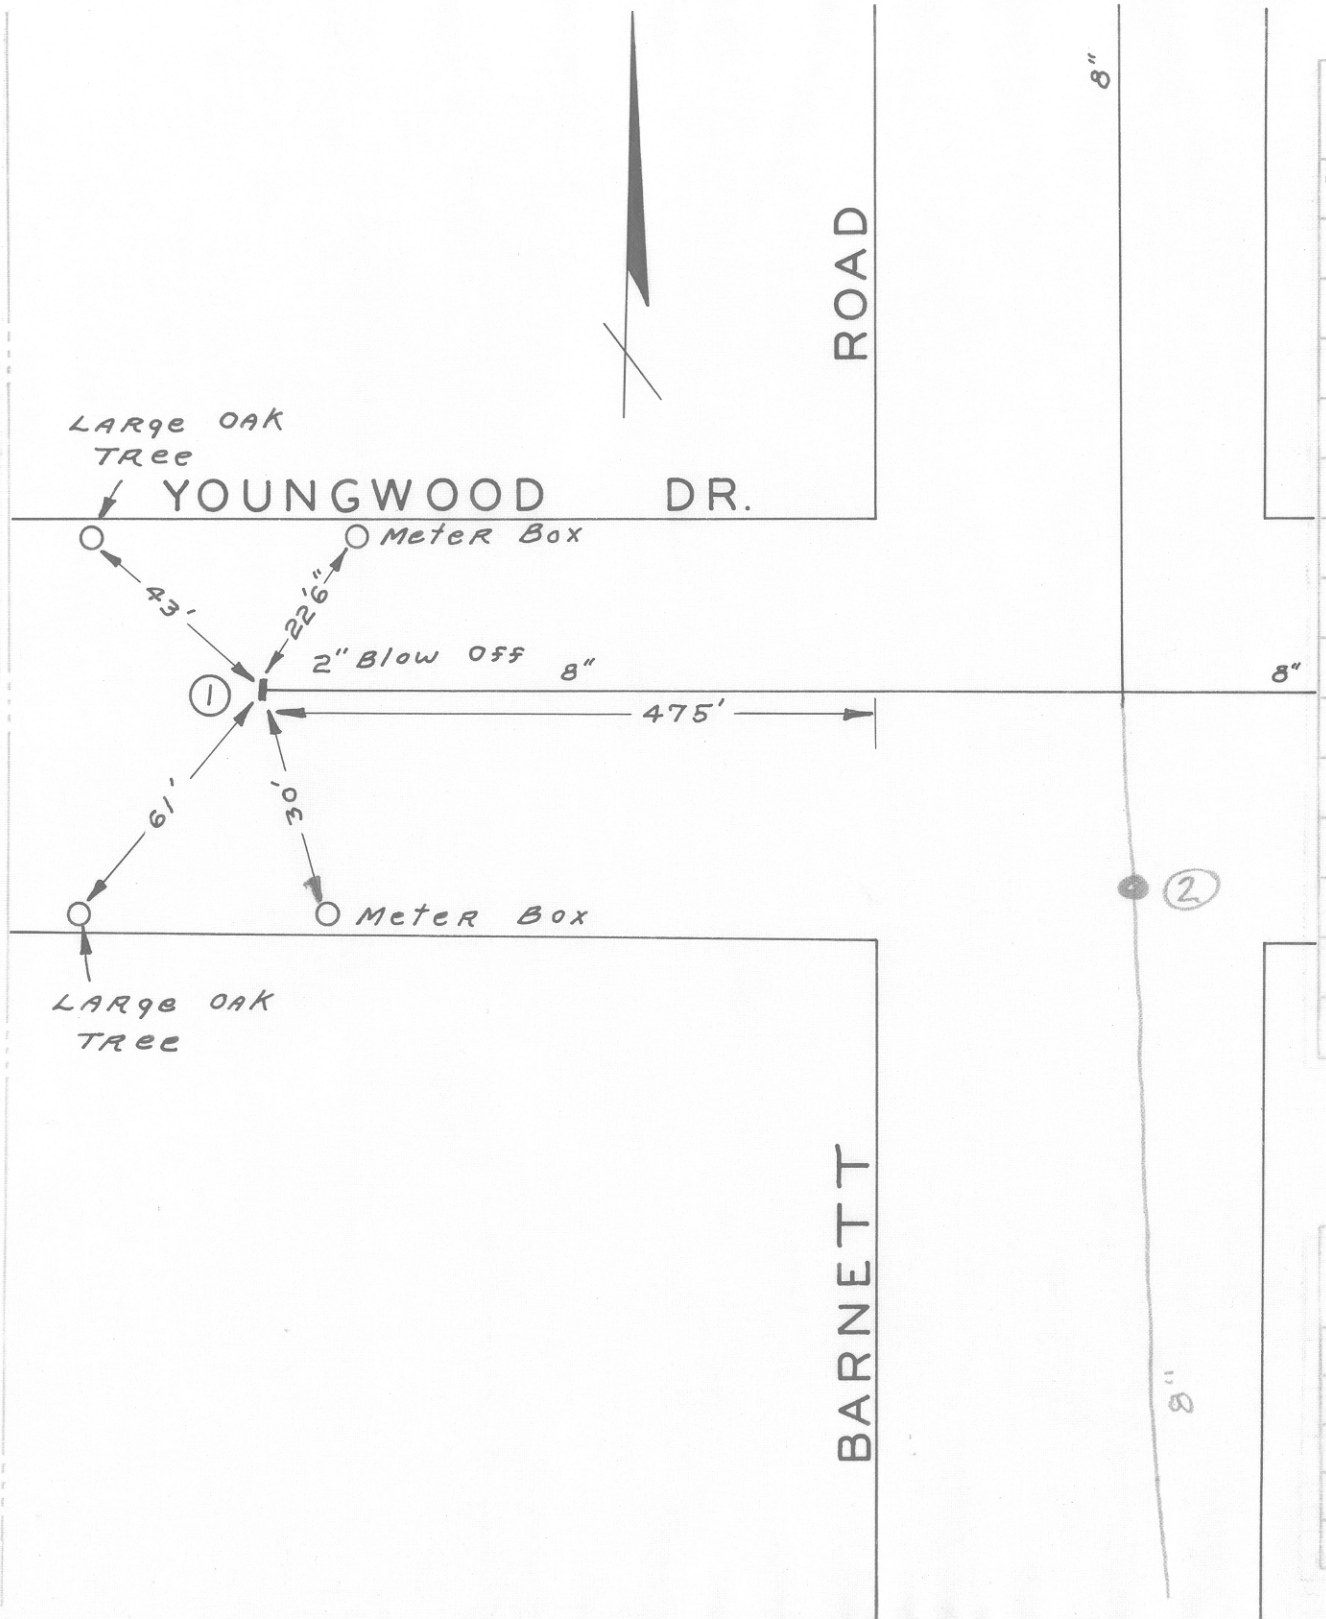

DATE	NO.	SIZE	MAKE	OPEN	TURNS
'58	1	2"	MISC.	L	8
1977	2				
	1	475'-W	WPL		

CITY OF ROANOKE—WATER DEPT.

VALVE DIAGRAM

YOUNGWOOD DRIVE

475-W. OF BARNETT

ROAD N. W.

SEC. MAP 8 613

DATE PAGE NO.