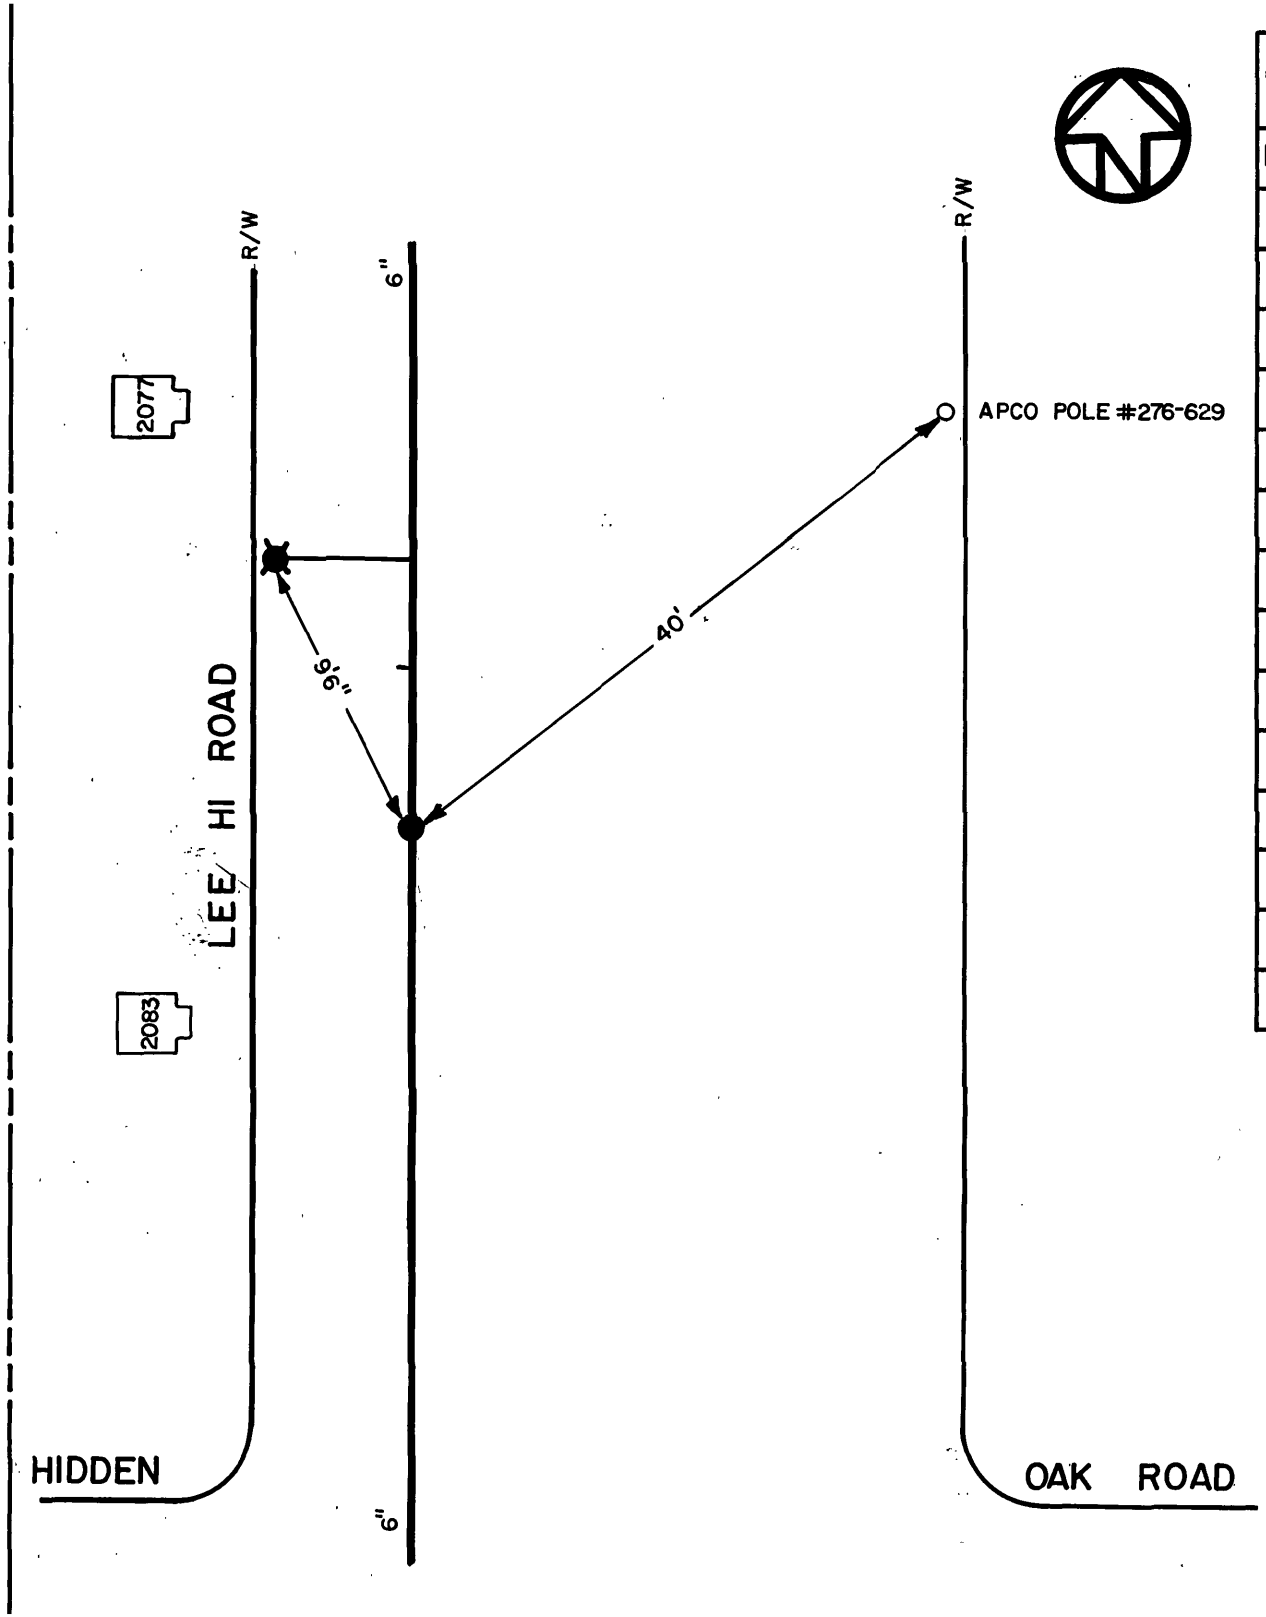

DATE	NO.	SIZE	MAKE	OPEN	TURNS
1993	1	6"	MUELLER	R	21

CITY OF ROANOKE - WATER DEP'T.

VALVE DIAGRAM

2077 LEE HI ROAD

SEC. MAP 501, 505 S.W.

DATE: PAGE NO.