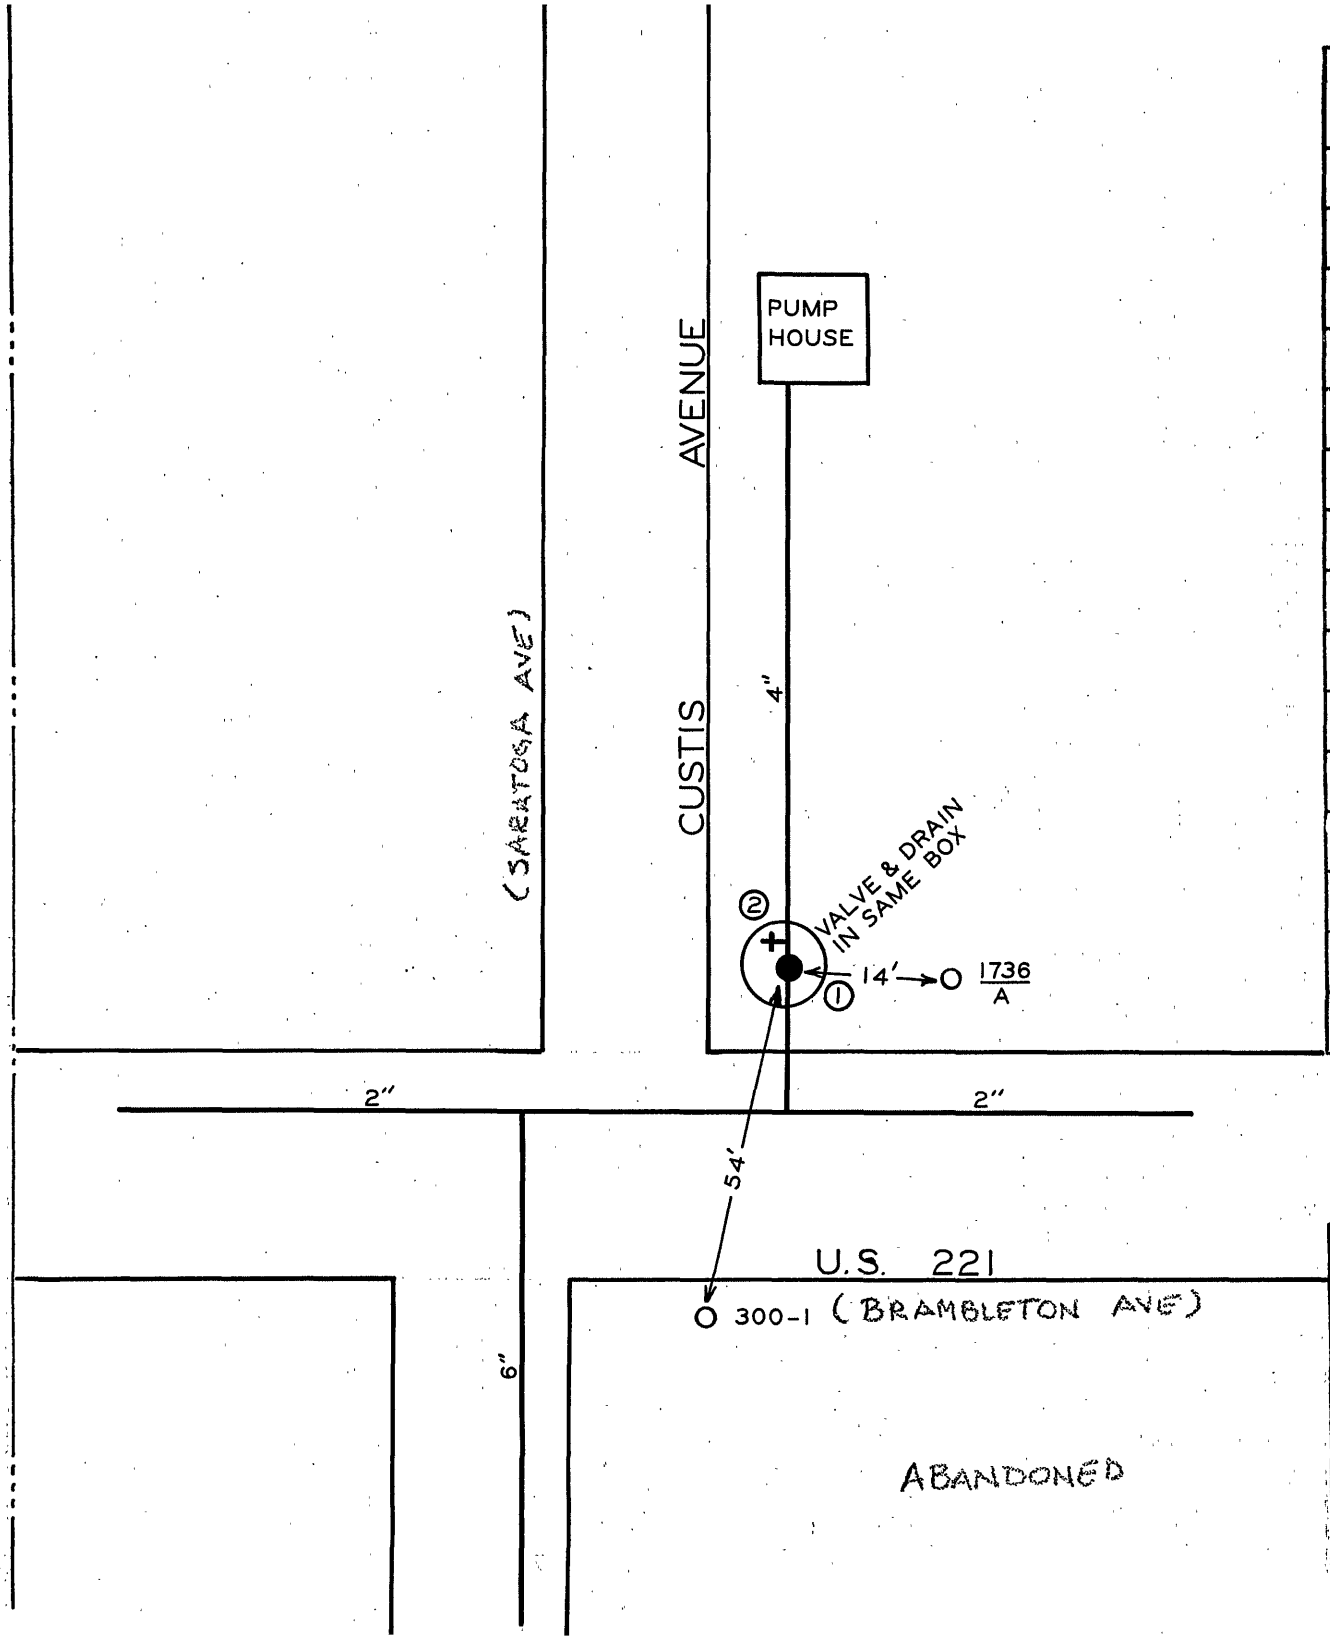

DATE	NO.	SIZE	MAKE	OPEN	TURNS
	1	4"		R	
	2	1/2"	CURBCOCK		

CITY OF ROANOKE—WATER DEPT.

VALVE DIAGRAM

221 PUMPING STATION

SEC. MAP

DATE **PAGE NO.**