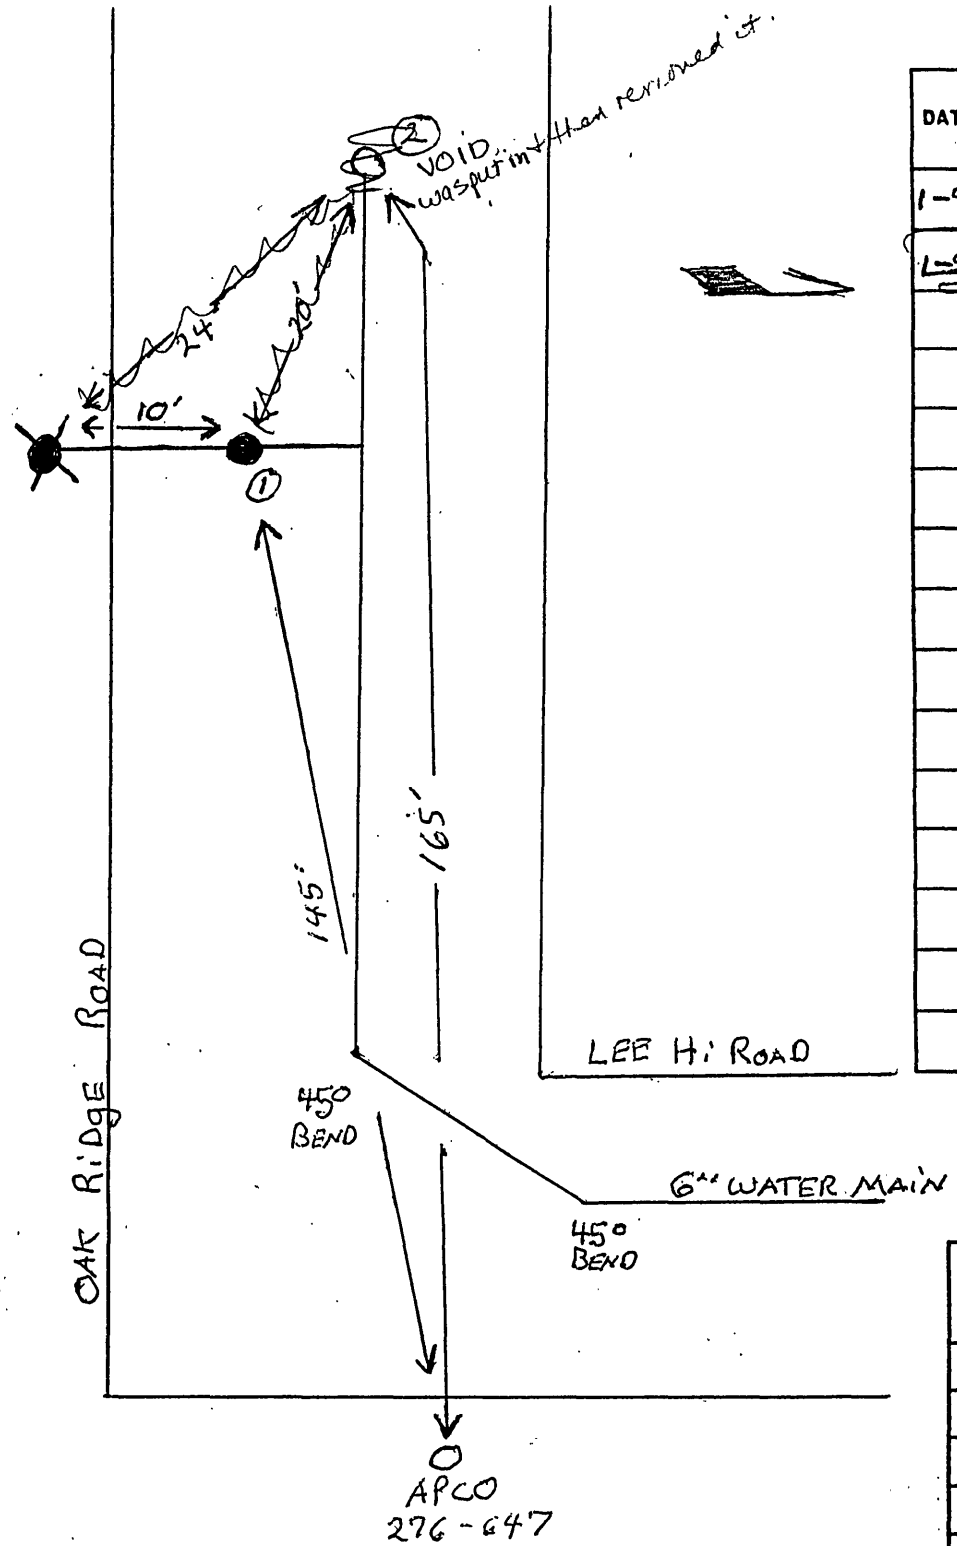

DATE	NO.	SIZE	MAKE	OPEN	TURNS
1-93	1	6"	MUELLER	R	21
~~1-93~~	~~2~~	~~2"~~	~~MISC.~~	~~L~~	~~80~~

CITY OF ROANOKE—WATER DEP'T

VALVE DIAGRAM

3200 Block OAK RIDGE RD.

SEC. MAP 505

DATE 1-28-93 PAGE NO.