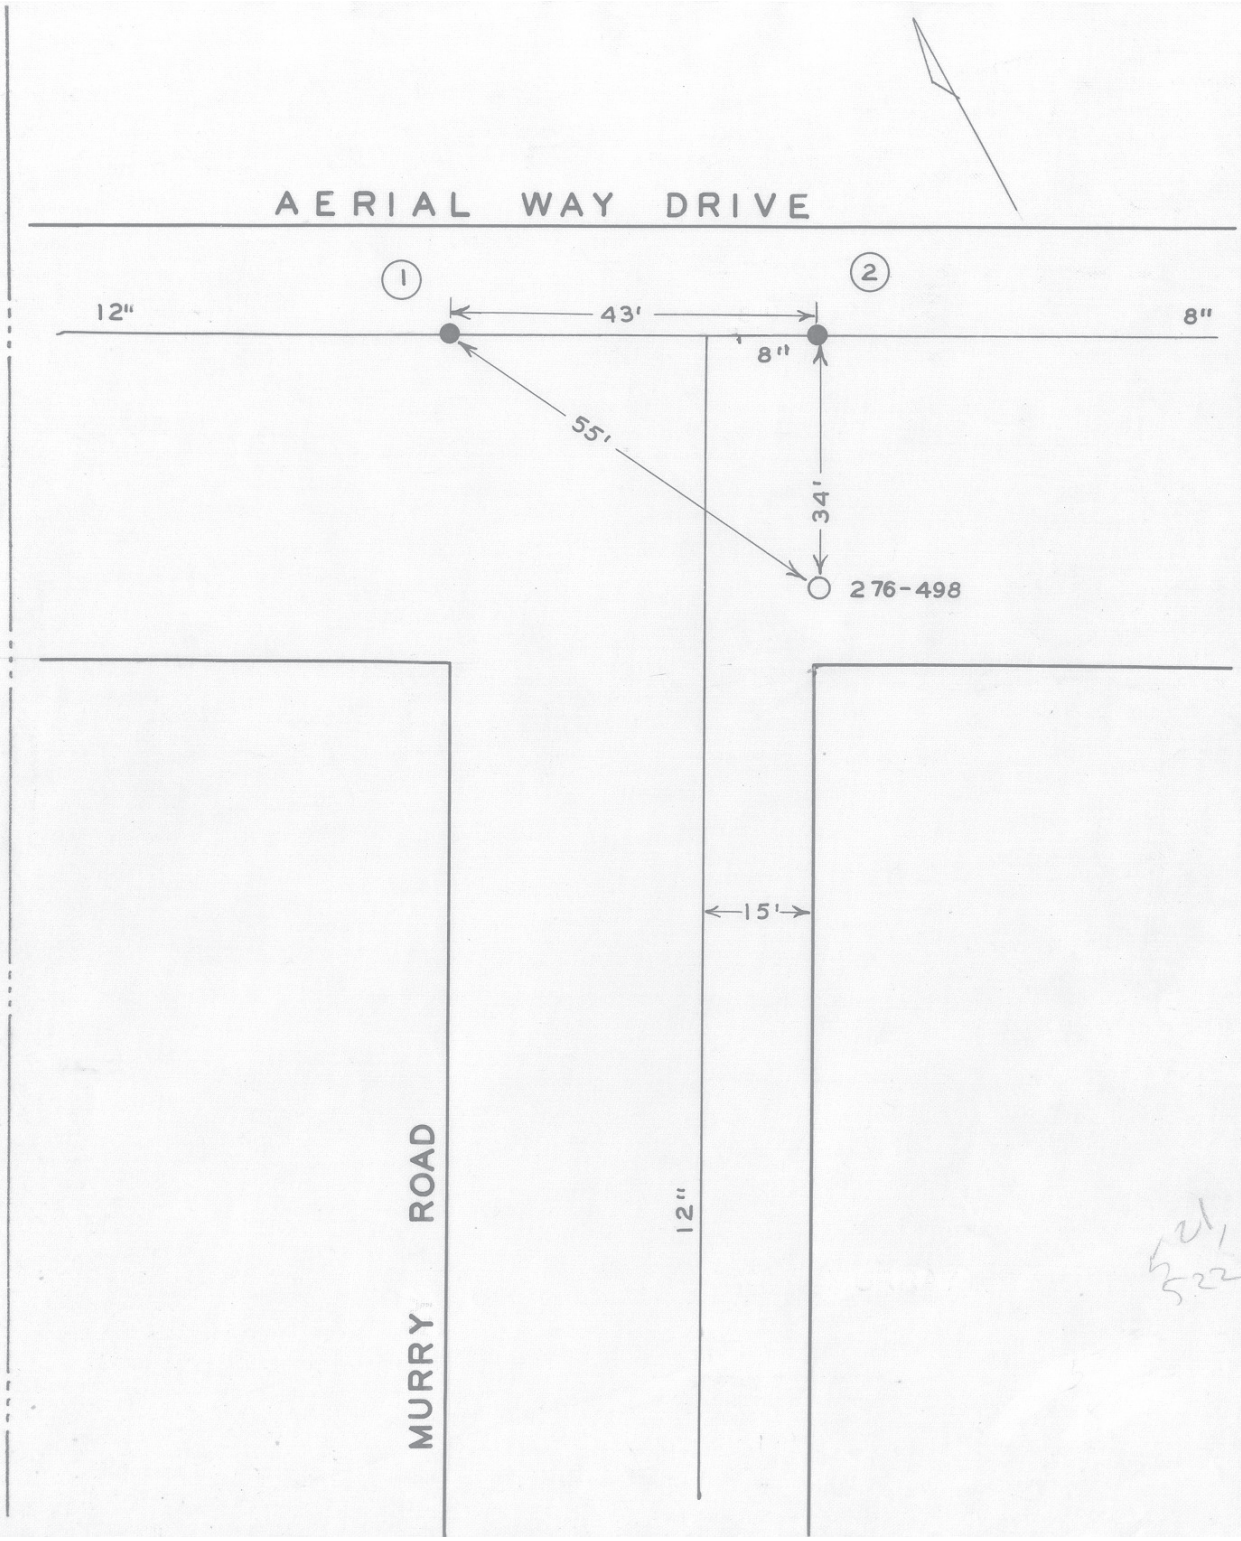

DATE	NO.	SIZE	MAKE	OPEN	TURNS
10-61	1	12"	MUELLER	R	38
10-61	2	8"	DARLING	R	26

CITY OF ROANOKE—WATER DEPT.

VALVE DIAGRAM

AERIAL WAY DRIVE &

MURRY ROAD S.W.

INDUSTRIAL PARK

SEC. MAP ~~43~~ 521, 522

DATE PAGE NO.