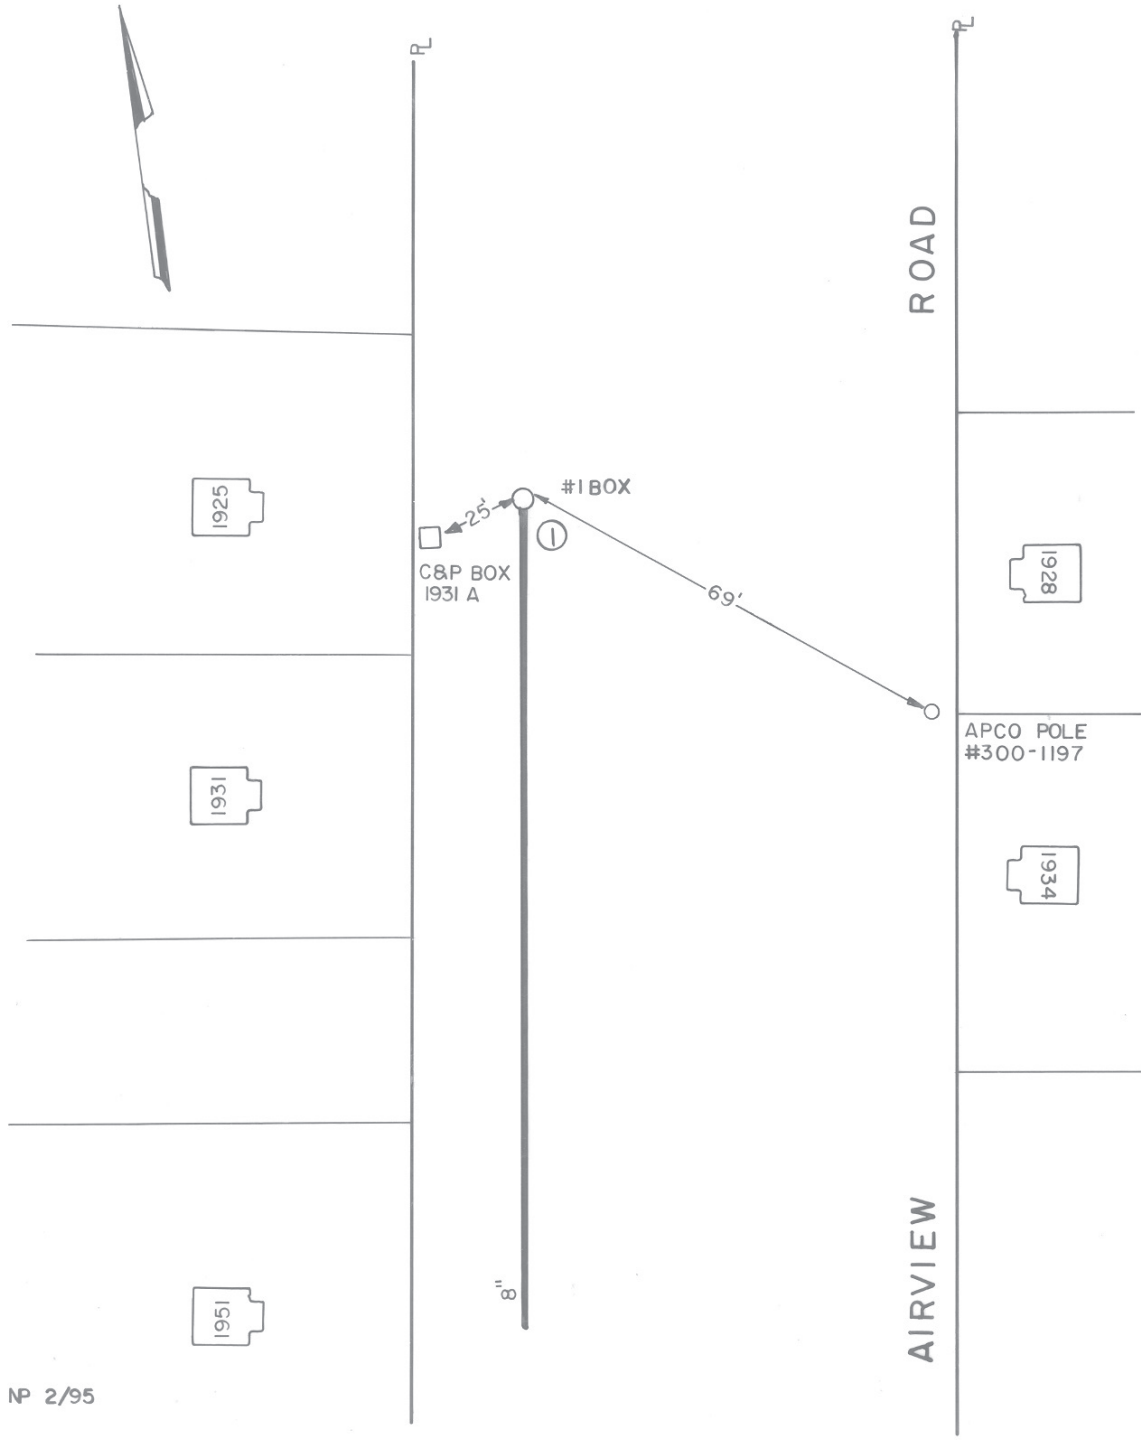

DATE	NO.	SIZE	MAKE	OPEN	TURNS
1988	1	2"	BLOWOFF		

CITY OF ROANOKE - WATER DEP'T.

VALVE DIAGRAM

AIRVIEW ROAD

SEC. MAP 508, 509 S.W.

DATE: PAGE NO.

NP 2/95