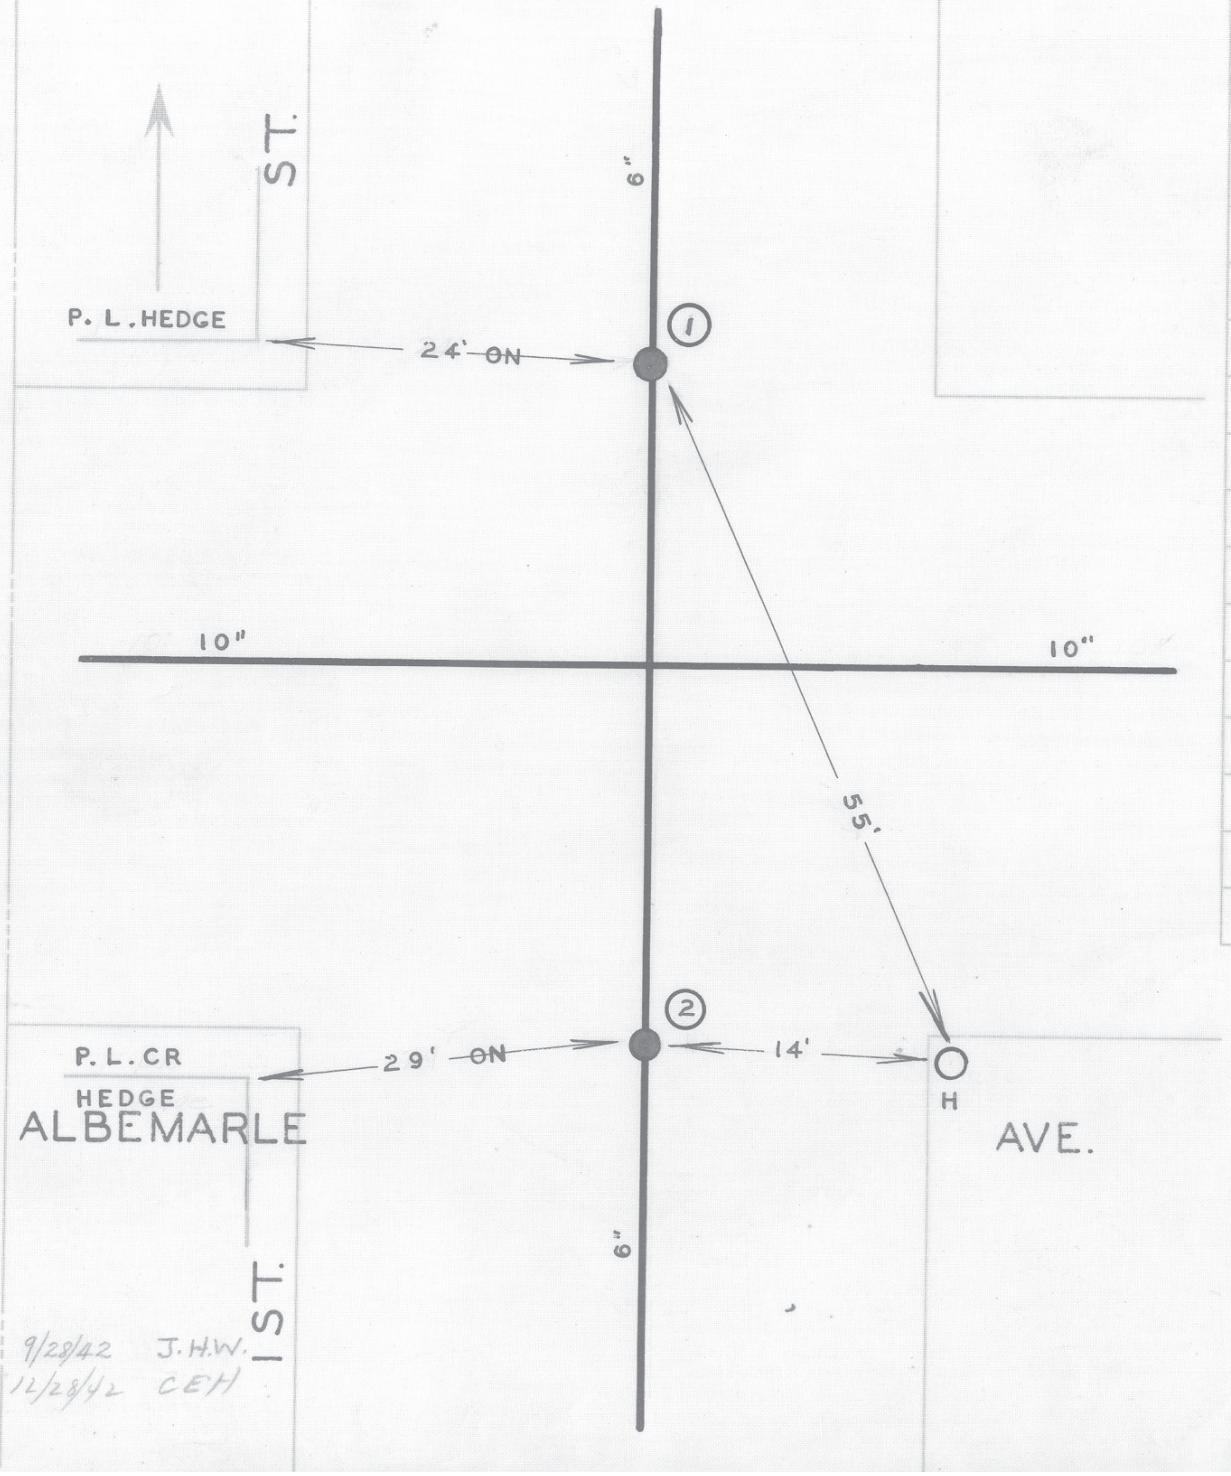

DATE	NO.	SIZE	MAKE	OPEN	TURNS
1943	1	6"	DARLING	R	21 1/2
1892	2	6"		R	20 1/2
	1	0	NPL		
	2	0	SPL		

CITY OF ROANOKE—WATER DEP'T

VALVE DIAGRAM

ALBEMARLE AVE. & 1ST. ST. S. W.

SEC. MAP 102

DATE

PAGE NO. S.W. 72