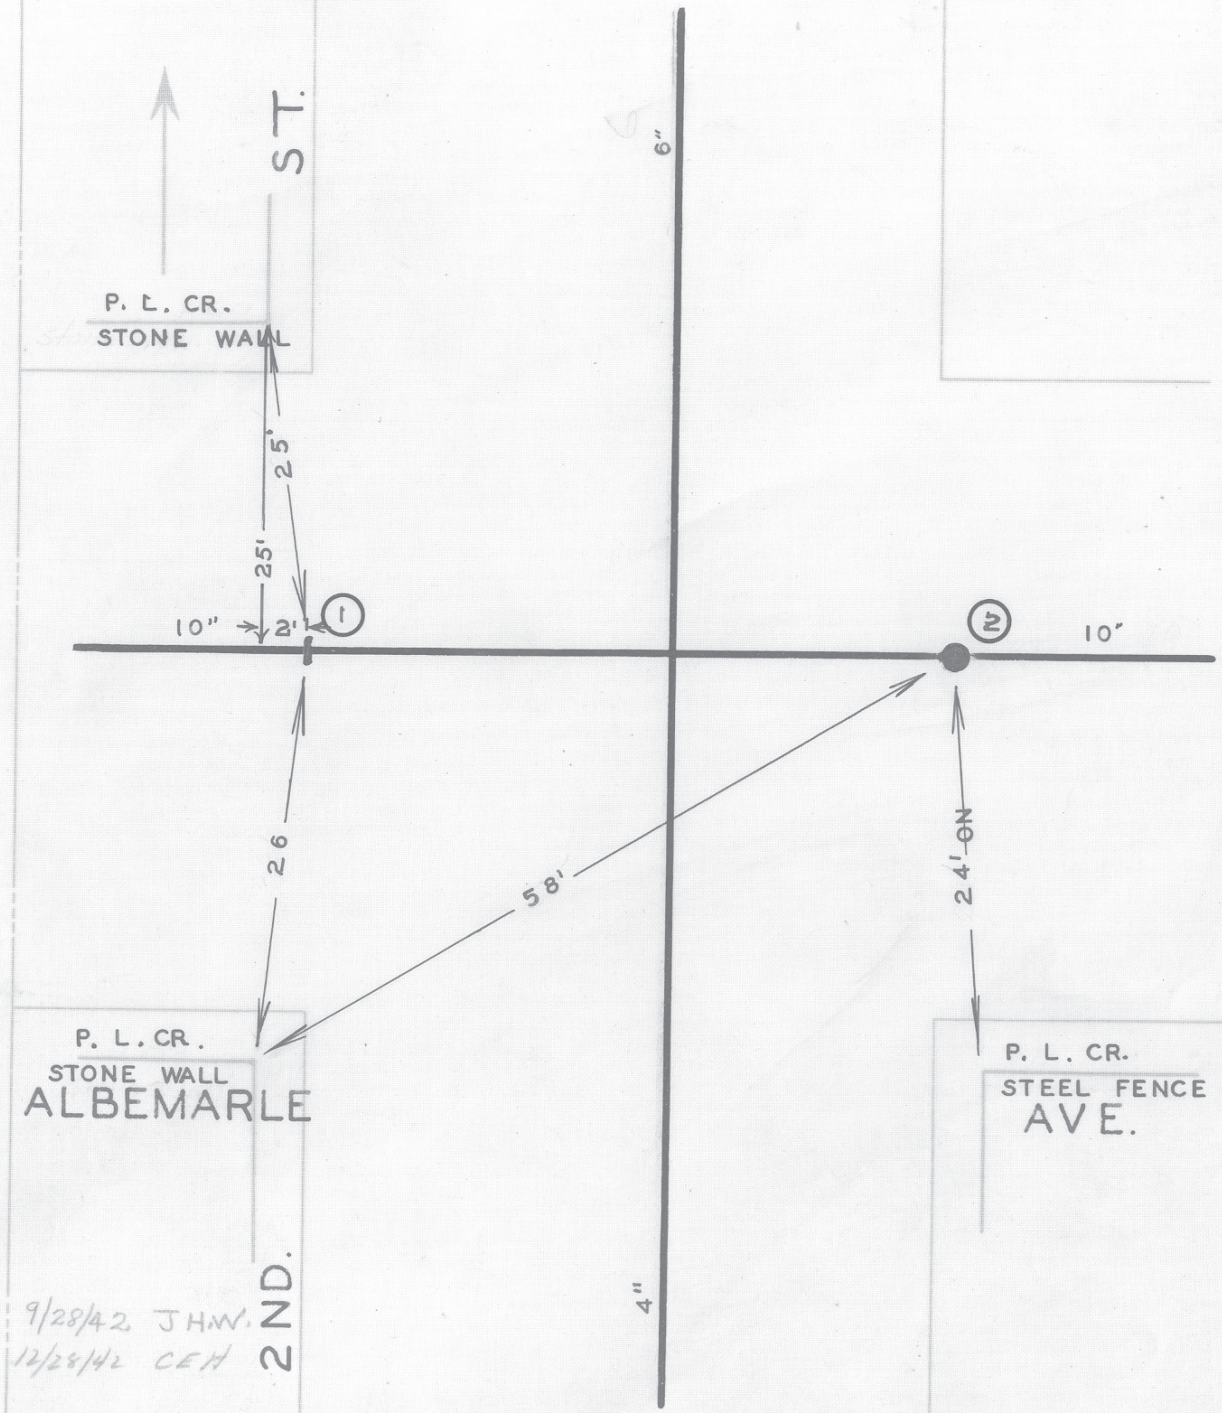

DATE	NO.	SIZE	MAKE	OPEN	TURNS
1890	1	10"		R	36
1890	2	10		R	36
	1	2'-E	WPL		
	2	0	EPL		

CITY OF ROANOKE—WATER DEP'T

VALVE DIAGRAM

ALBEMARLE AVE. & 2ND. ST. S. W.

SEC. MAP 102

DATE

PAGE NO S.W.73