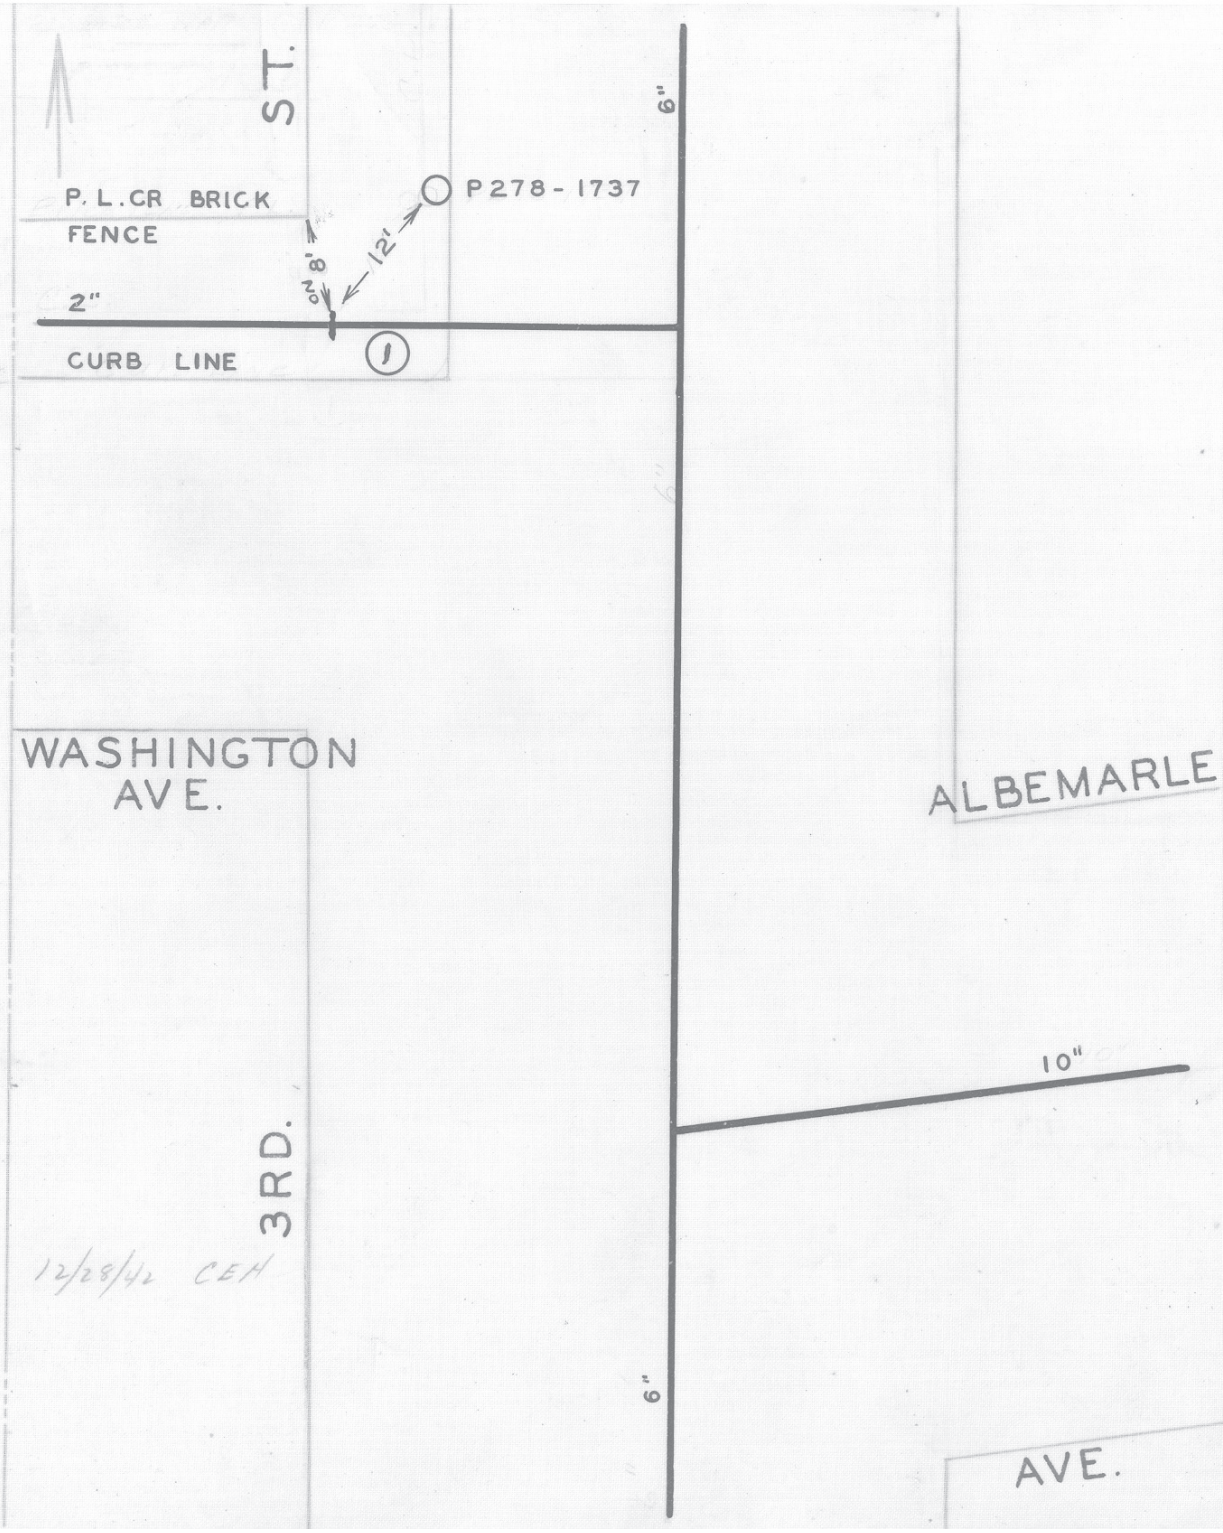

DATE	NO.	SIZE	MAKE	OPEN	TURNS
1924	1	2"		R	7
	1	0	WPL		

CITY OF ROANOKE—WATER DEP'T

VALVE DIAGRAM

ALBEMARLE AVE & 3RD.
&WASHINGTON AVE. S. W.

SEC. MAP 102

DATE PAGE NO. S.W. 68