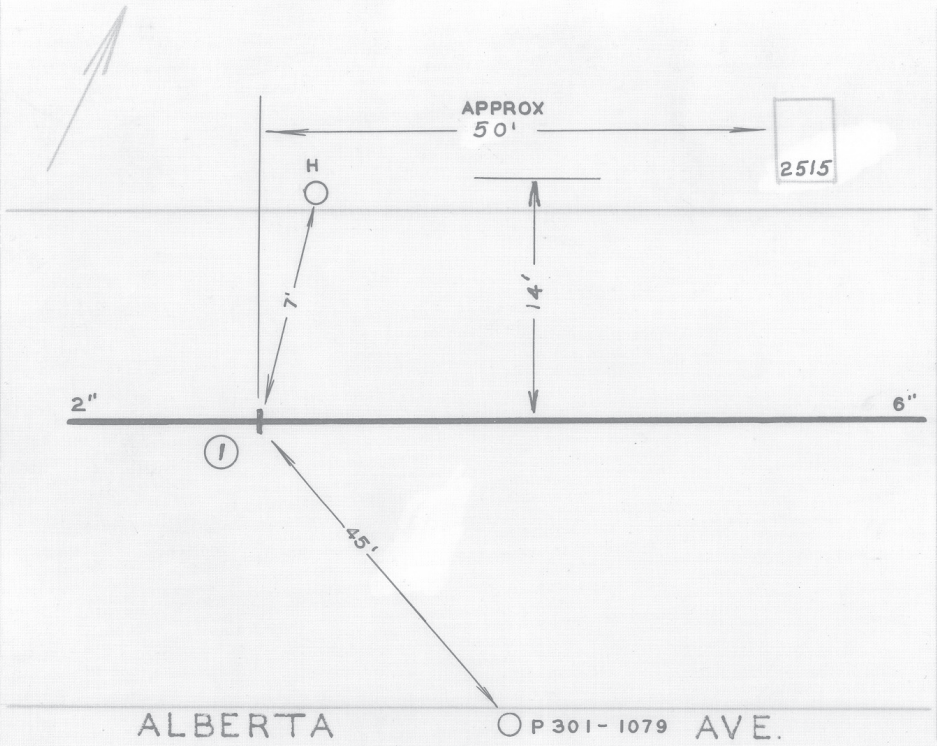

DATE	NO.	SIZE	MAKE	OPEN	TURNS
1939	1	2"		R	7
	1	310'-W	WPL		

10/24/42 J.H.W.
CEH

CITY OF ROANOKE—WATER DEP'T
VALVE DIAGRAM
ALBERTA APROX 50' W.
OF HOUSE NO. 2515

SEC. MAP 155
DATE
PAGE NO. S.W. 474