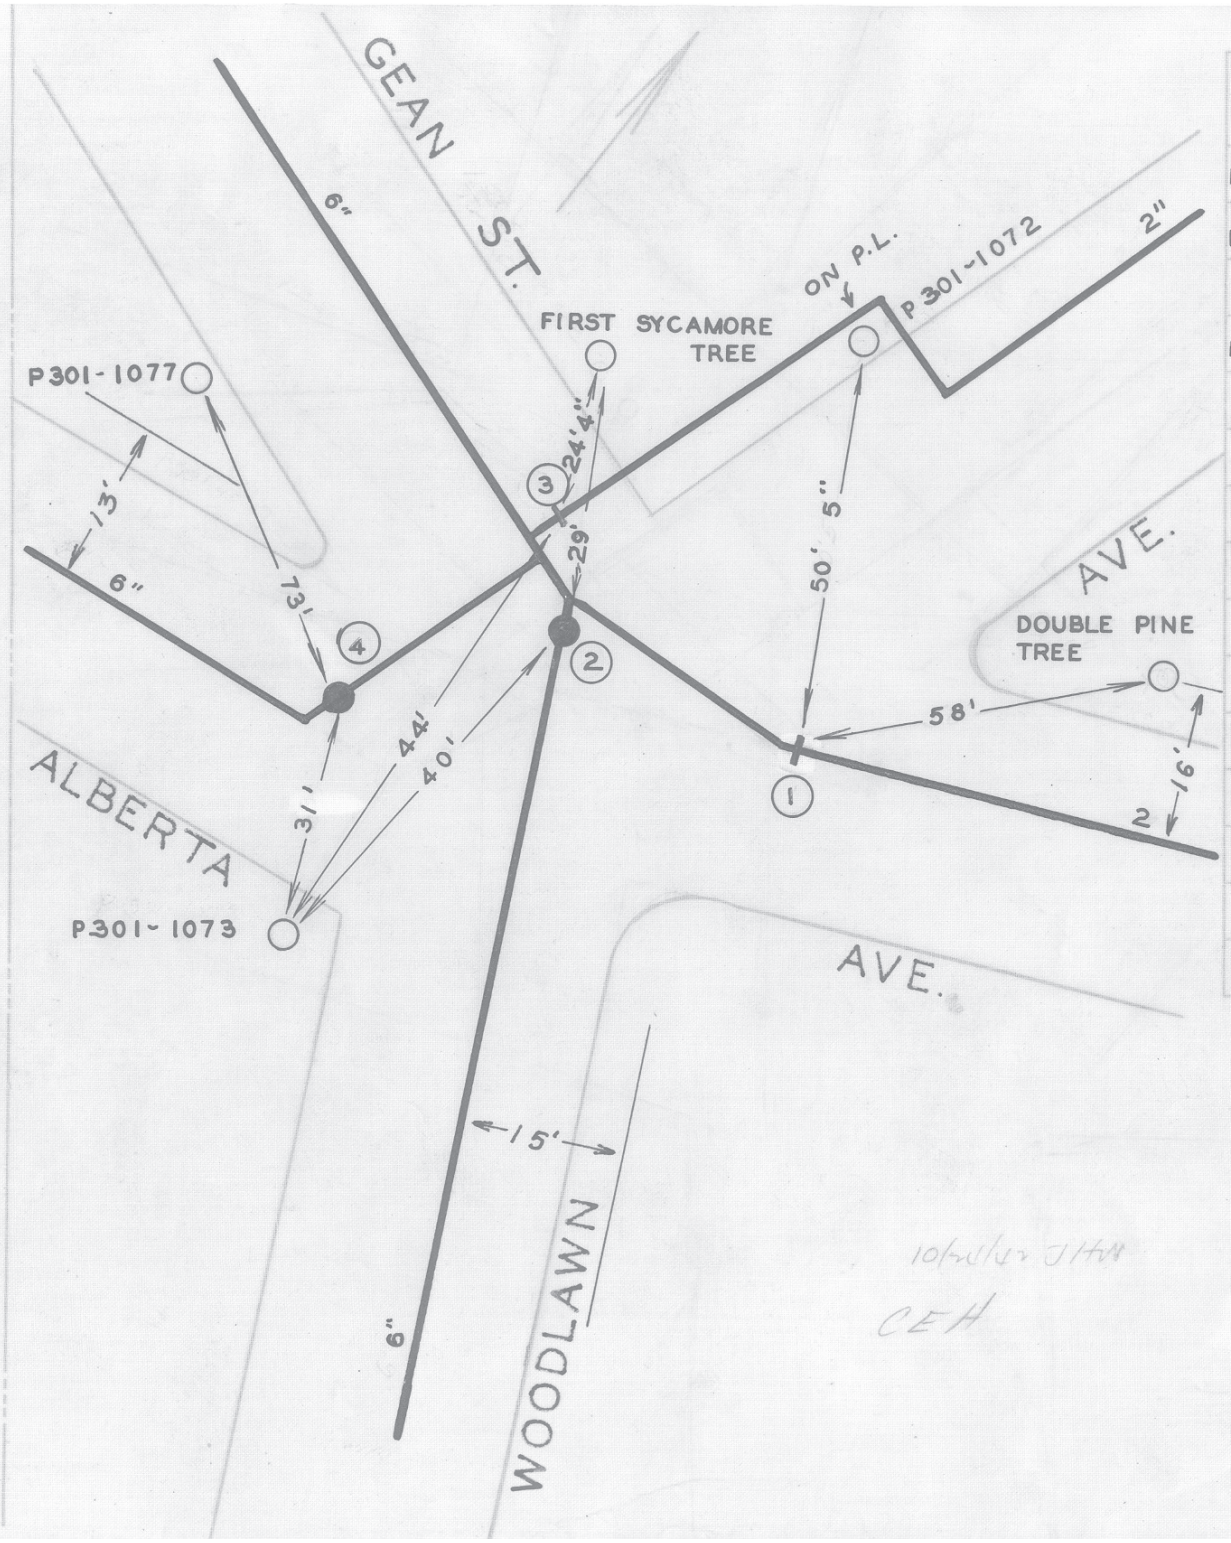

DATE	NO.	SIZE	MAKE	OPEN	TURNS
1924	1	2"		R	7
1924	2	6"		R	20 1/2
1924	3	2"		R	7
1939	4	6"		R	21
	1	4'-W	EPL		
	2	20'-N	SPL		
	3	11'-W	EPL		
	4	4'-E	WPL		


CEH

CITY OF ROANOKE—WATER DEP'T

VALVE DIAGRAM

ALBERTA AVE.-GEAN ST. &

WOODLAWN AVE. S.W.

SEC. MAP 155

DATE

PAGE NO. S.W.473