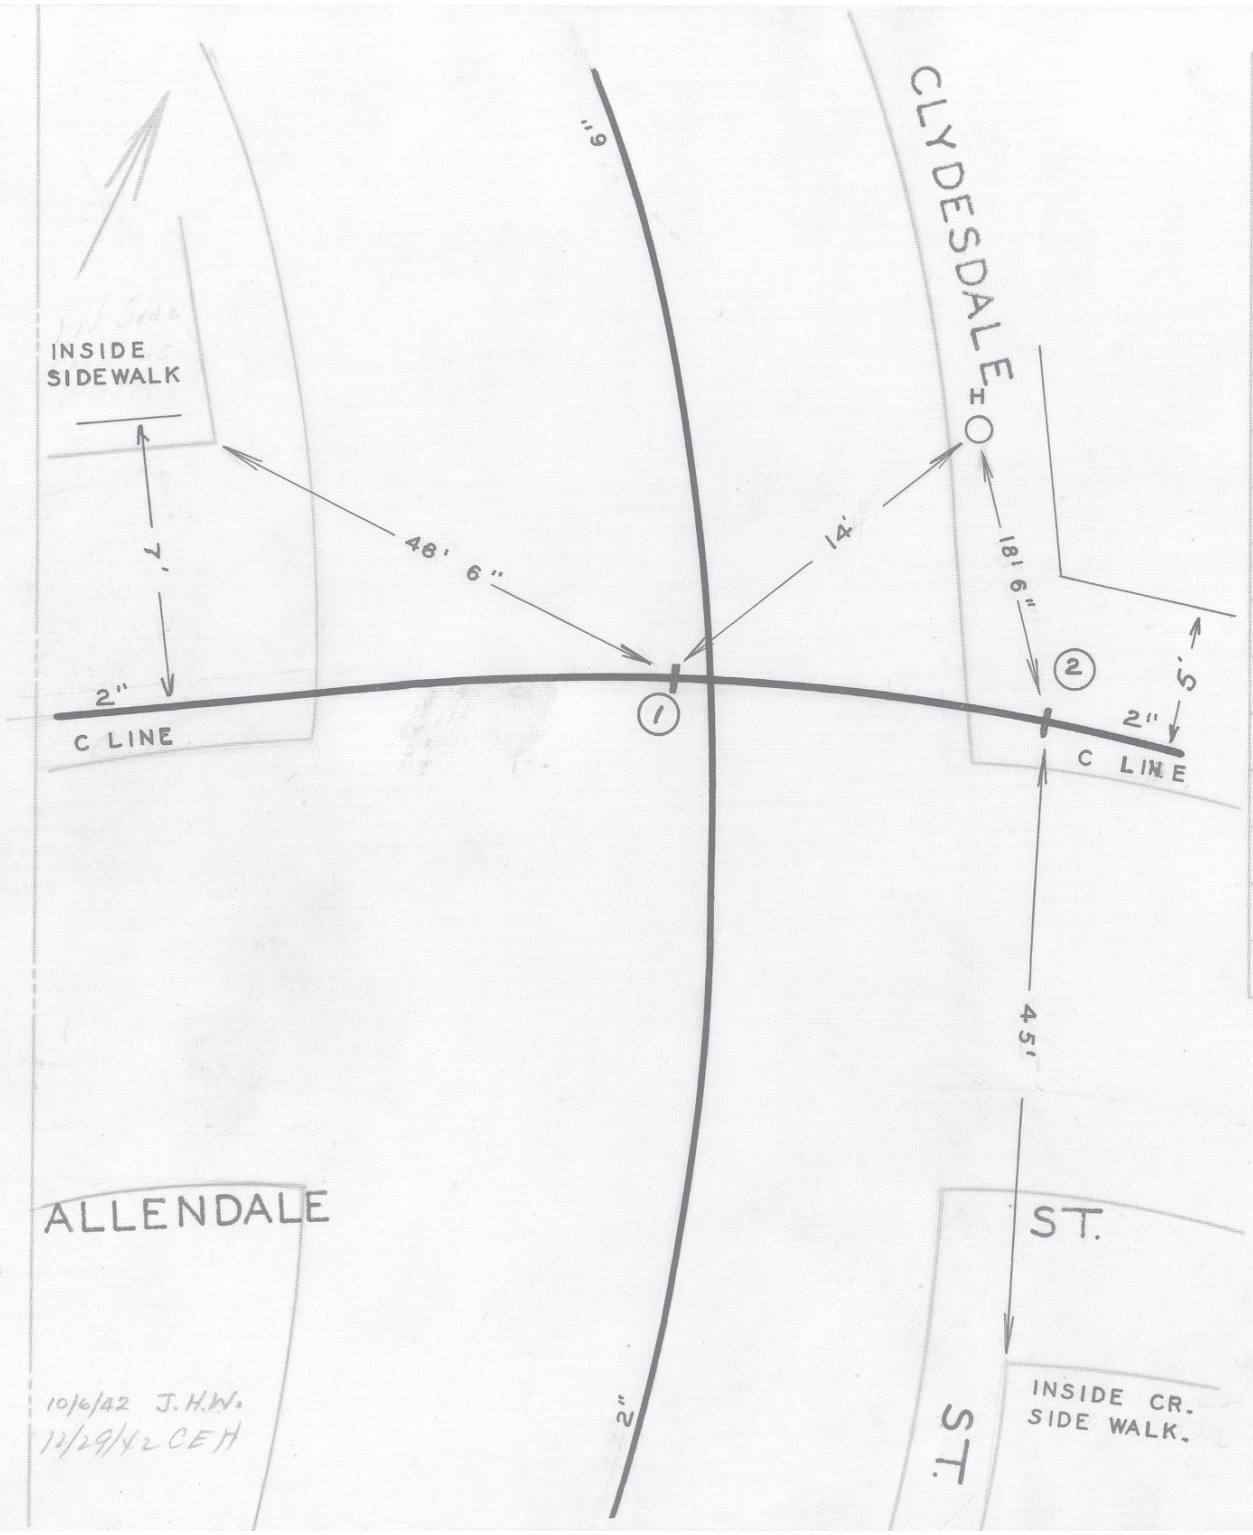

DATE	NO.	SIZE	MAKE	OPEN	TURNS
1927	1	2"		R	8 1/2
1927	2	2"		L.	9
	1	47'-E	WPL		
	2	8'-E	E PL		

CITY OF ROANOKE—WATER DEP'T

VALVE DIAGRAM

ALLENDALE ST &

CLYDESDALE ST. S.W.

SEC. MAP 107

DATE

PAGE NO. S.W. 292