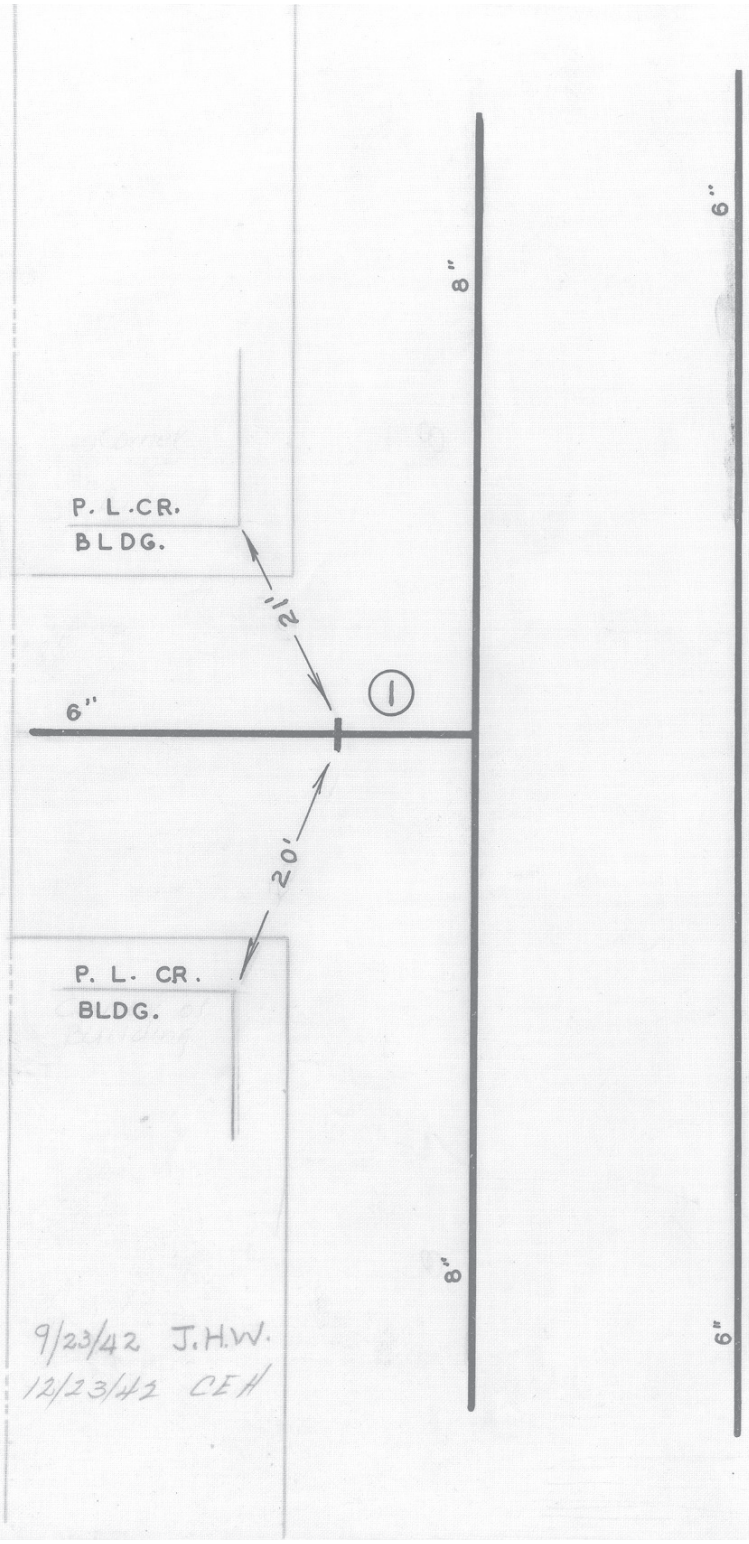

DATE	NO.	SIZE	MAKE	OPEN	TURNS
1889	1	6"	ON SERVICE		

CITY OF ROANOKE—WATER DEP'T

VALVE DIAGRAM

ALLEY FROM 2ND. ST.
BETWEEN CAMPBELL AVE.
& SALEM AVE, S. W.

SEC. MAP 101

DATE PAGE NO S.W. 18