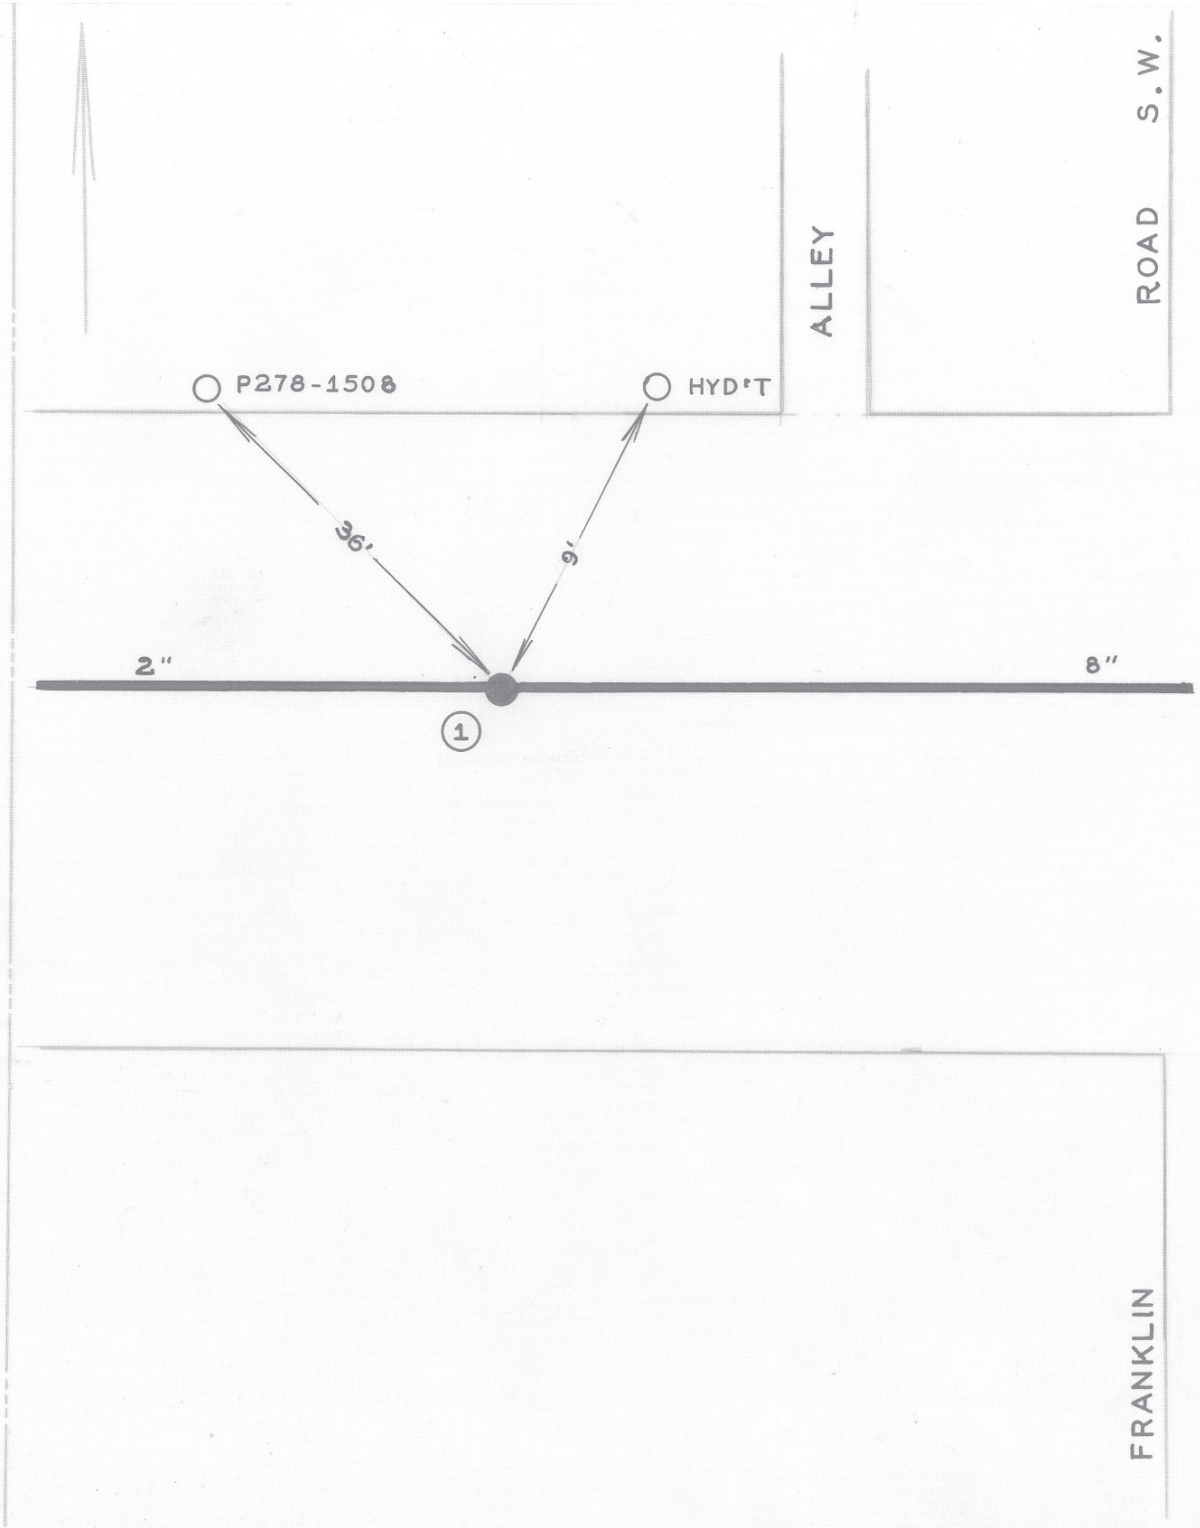

DATE	NO.	SIZE	MAKE	OPEN	TURNS
1948	1	8"	DARLING	R	27

CITY OF ROANOKE—WATER DEP'T

VALVE DIAGRAM

ALLISON AVENUE
WEST OF FRANKLIN
ROAD S.W.

SEC. MAP 103

DATE 8/24/48 PAGE NO. S.W.559