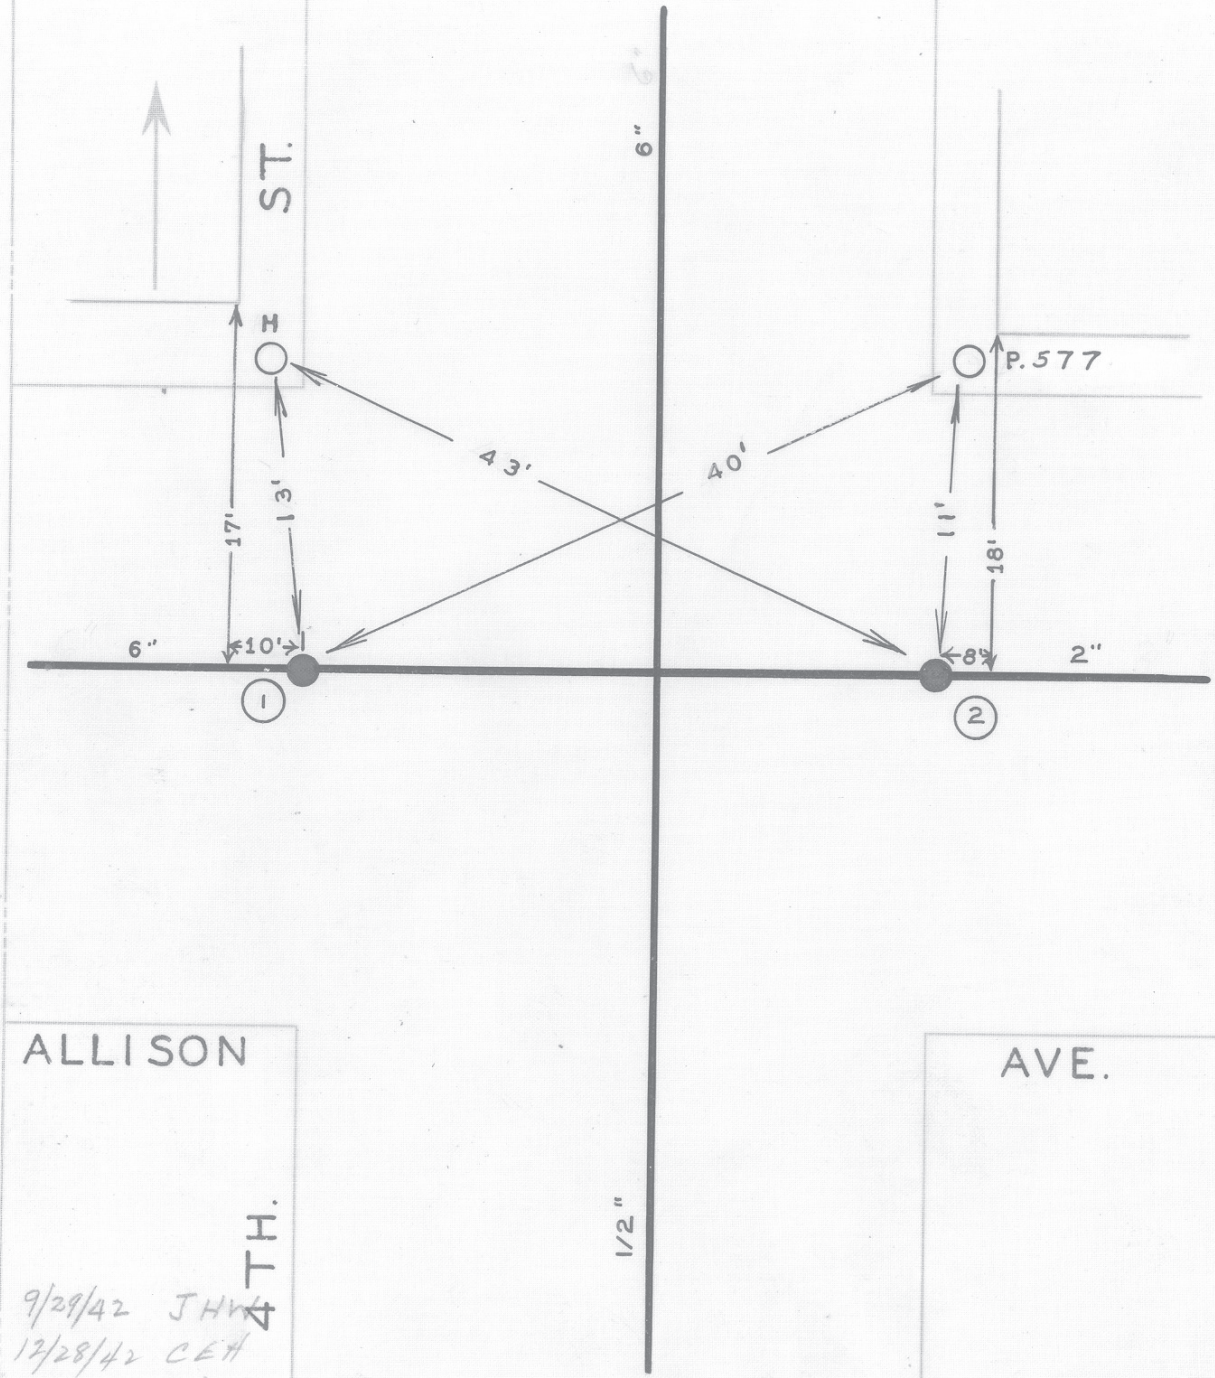

9/29/42 JHW
12/28/42 CEH

DATE	NO.	SIZE	MAKE	OPEN	TURNS
1906	1	6"		R	13
1904	2	2"		L	7
	1	10'-E	WPL		
	2	8'-W	EPL		

CITY OF ROANOKE—WATER DEP'T

VALVE DIAGRAM

ALLISON AVE & 4TH. ST S. W.

SEC. MAP 103

DATE

PAGE NO. S.W.87