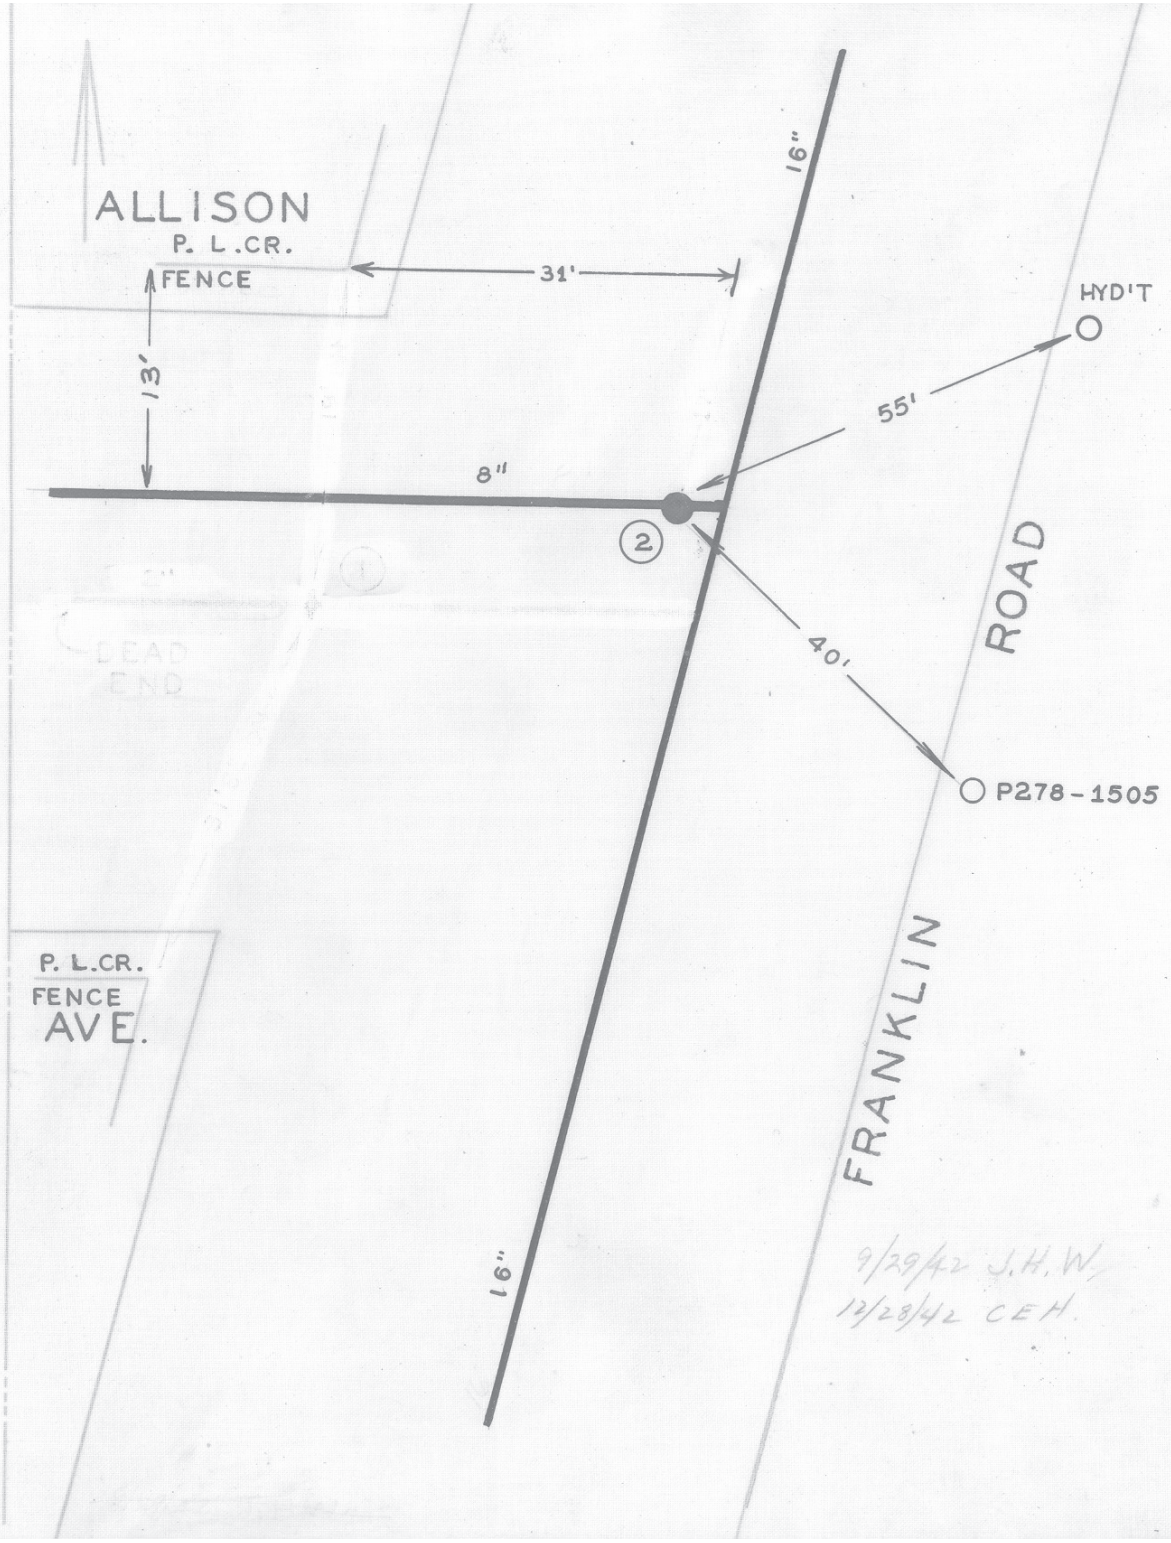

DATE	NO.	SIZE	MAKE	OPEN	TURNS
1948	2	8"	DARLING	R	27
	2	31'-E	WPL		

CITY OF ROANOKE—WATER DEP'T
VALVE DIAGRAM

ALLISON AVE. &
FRANKLIN ROAD S. W.

SEC. MAP 103

DATE PAGE NO. S.W. 86