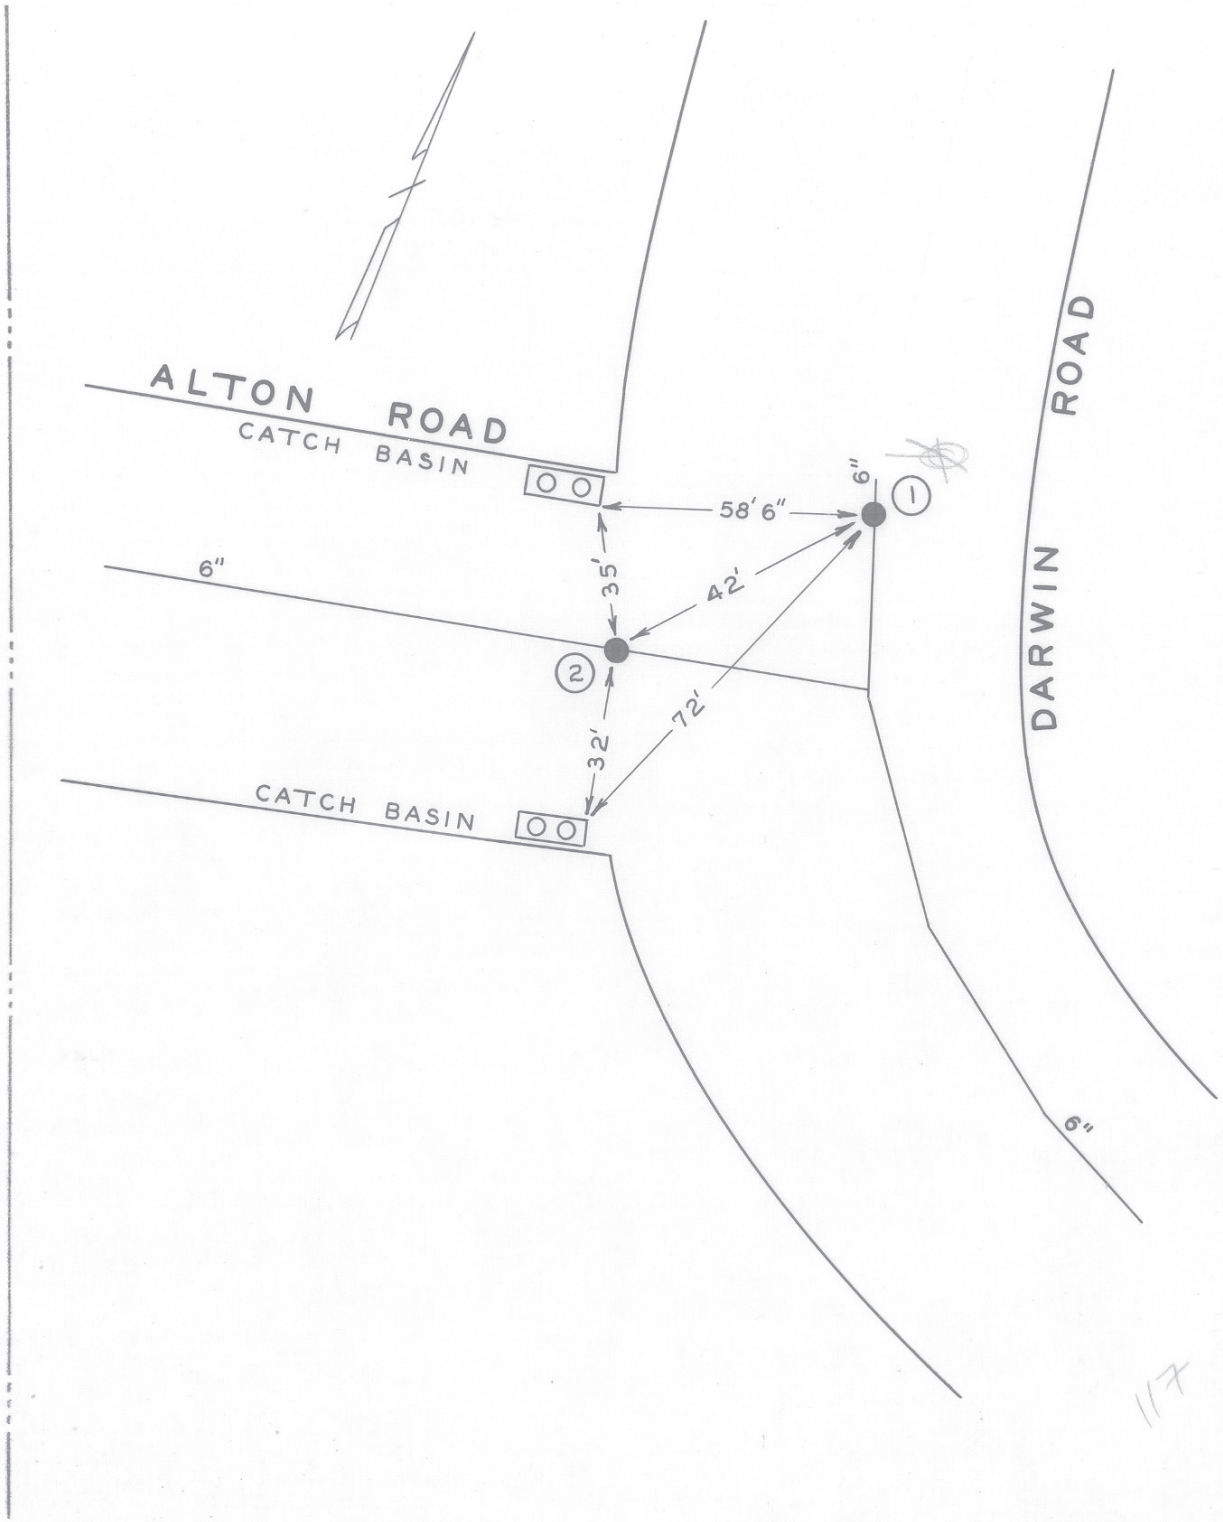

DATE	NO.	SIZE	MAKE	OPEN	TURNS
'62	1	6"	DAR.	R	20
'62	2	6"	DAR.	R	20
	1	?			
	2	0	WPL		

CITY OF ROANOKE — WATER DEPT.

VALVE DIAGRAM

ALTON ROAD &

DARWIN ROAD S. W.

SEC. MAP 45

DATE PAGE NO.

117