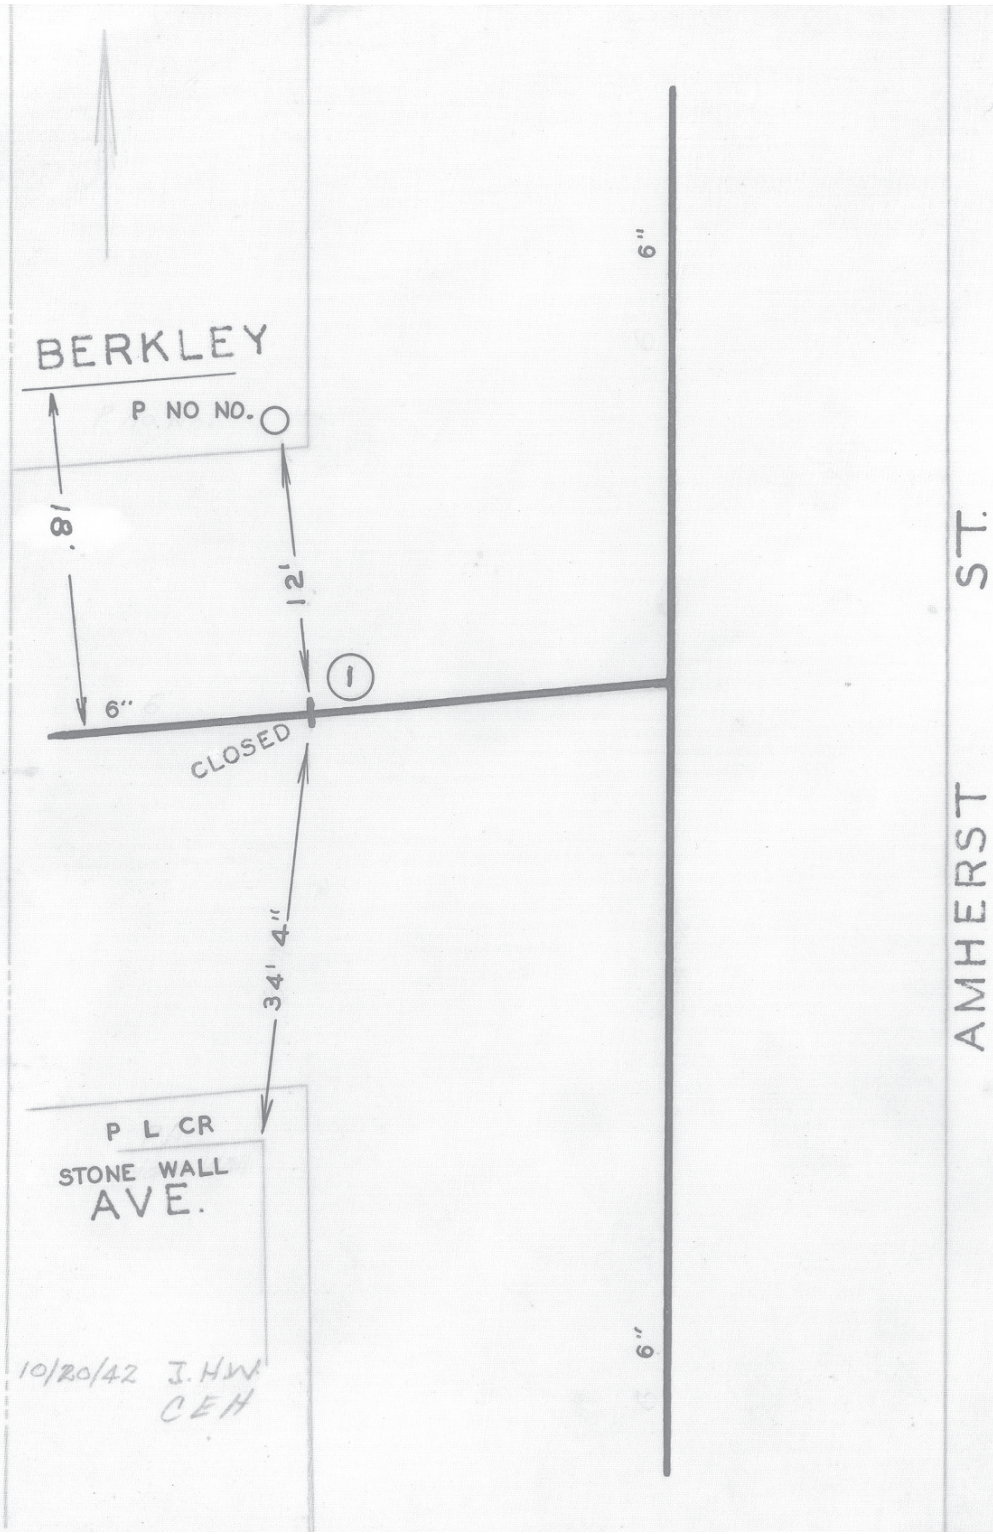

DATE	NO.	SIZE	MAKE	OPEN	TURNS
1921	1	6"		R	20
	1	8'-E	WPL		

CITY OF ROANOKE—WATER DEP'T

VALVE DIAGRAM

AMHERST ST. & BERKLEY AVE. S. W.

SEC. MAP 143

DATE

PAGE NO S.W.407