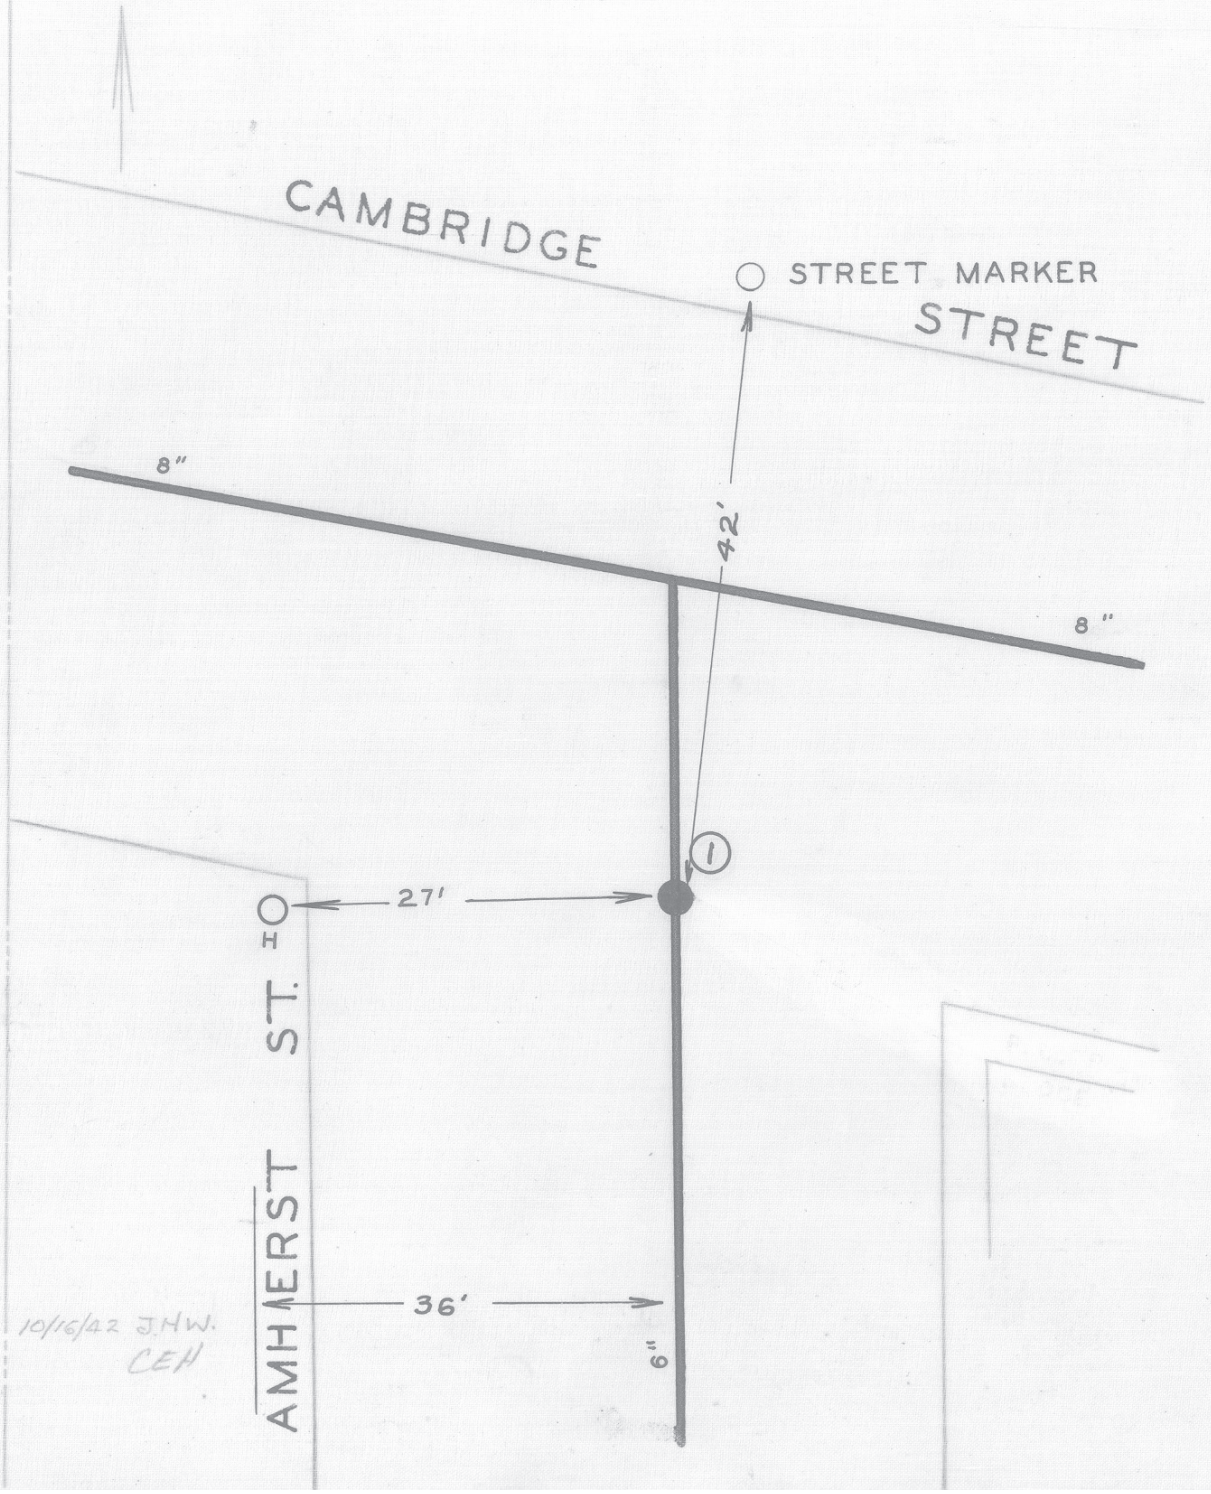

DATE	NO.	SIZE	MAKE	OPEN	TURNS
1910	1	6"		R	13
	1	8" N	SPL		

CITY OF ROANOKE—WATER DEP'T

VALVE DIAGRAM

AMHERST ST. & CAMBRIDGE ST. S. W.

SEC. MAP 133

DATE

PAGE NO. S.W. 359