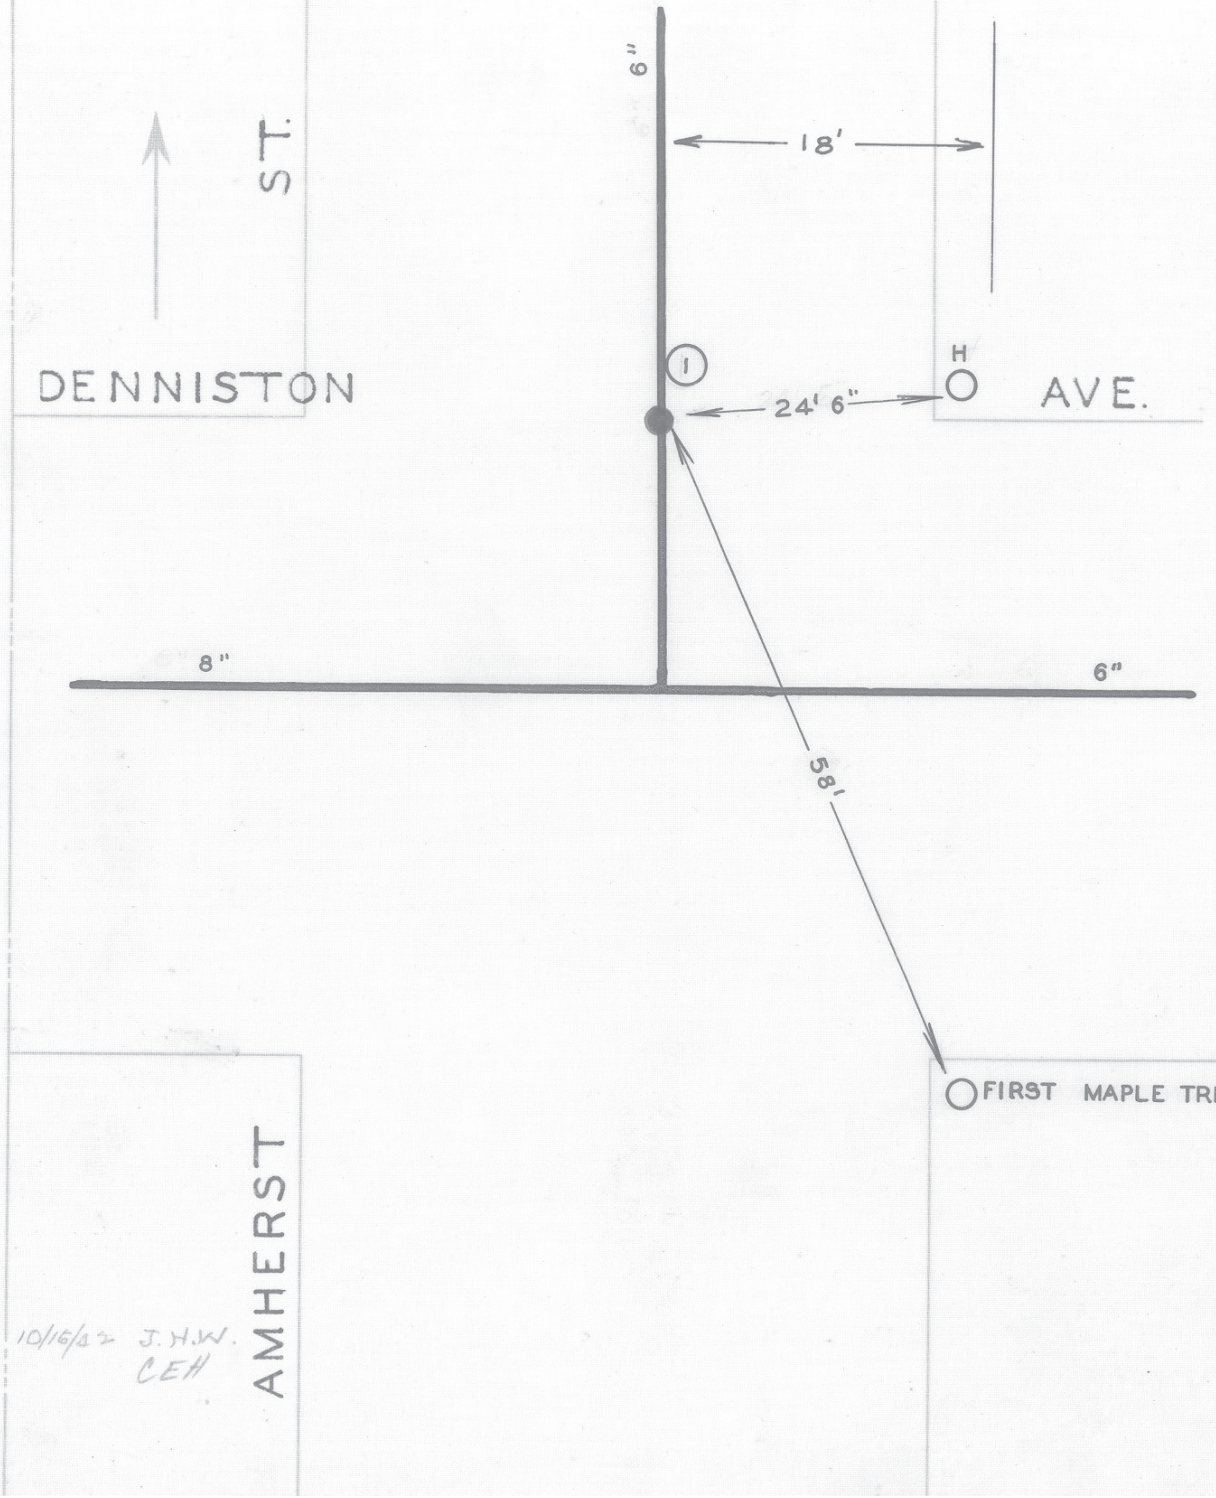

DATE	NO.	SIZE	MAKE	OPEN	TURNS
1925	1	6"		R	20
	1	3'-S	NPL		

CITY OF ROANOKE—WATER DEP'T

VALVE DIAGRAM

AMHERST ST. & DENNISTON AVE. S. W.

SEC. MAP 133

DATE

PAGE NO S.W. 360