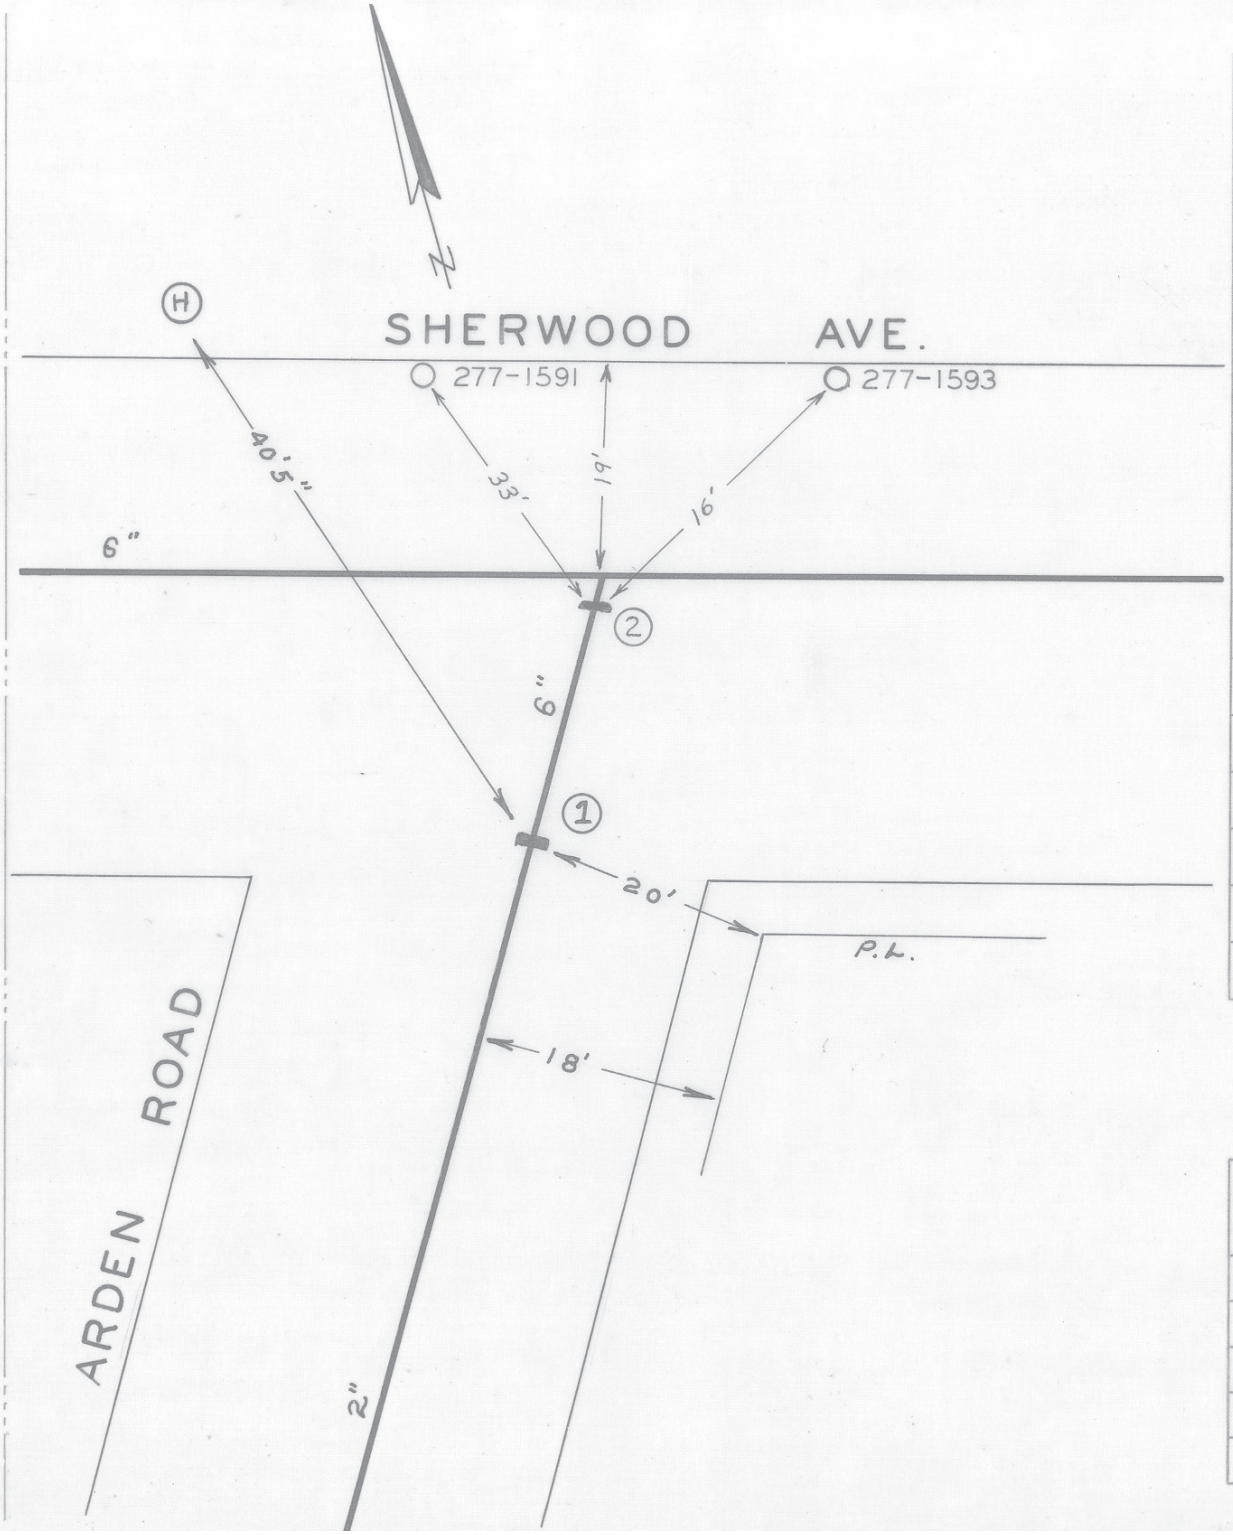

DATE	NO.	SIZE	MAKE	OPEN	TURNS
1922	1	2"		R	7
8-68	2	6"	MUELLER	R	
	1	11'-N	SPL		
	2	19'-S	NPL		

CITY OF ROANOKE — WATER DEPT.

VALVE DIAGRAM

ARDEN RD. & SHERWOOD AVE. S.W.

SEC. MAP 144

DATE PAGE NO.

"IMPERIAL" TRACING CLOTH
K & E CO., N. Y.