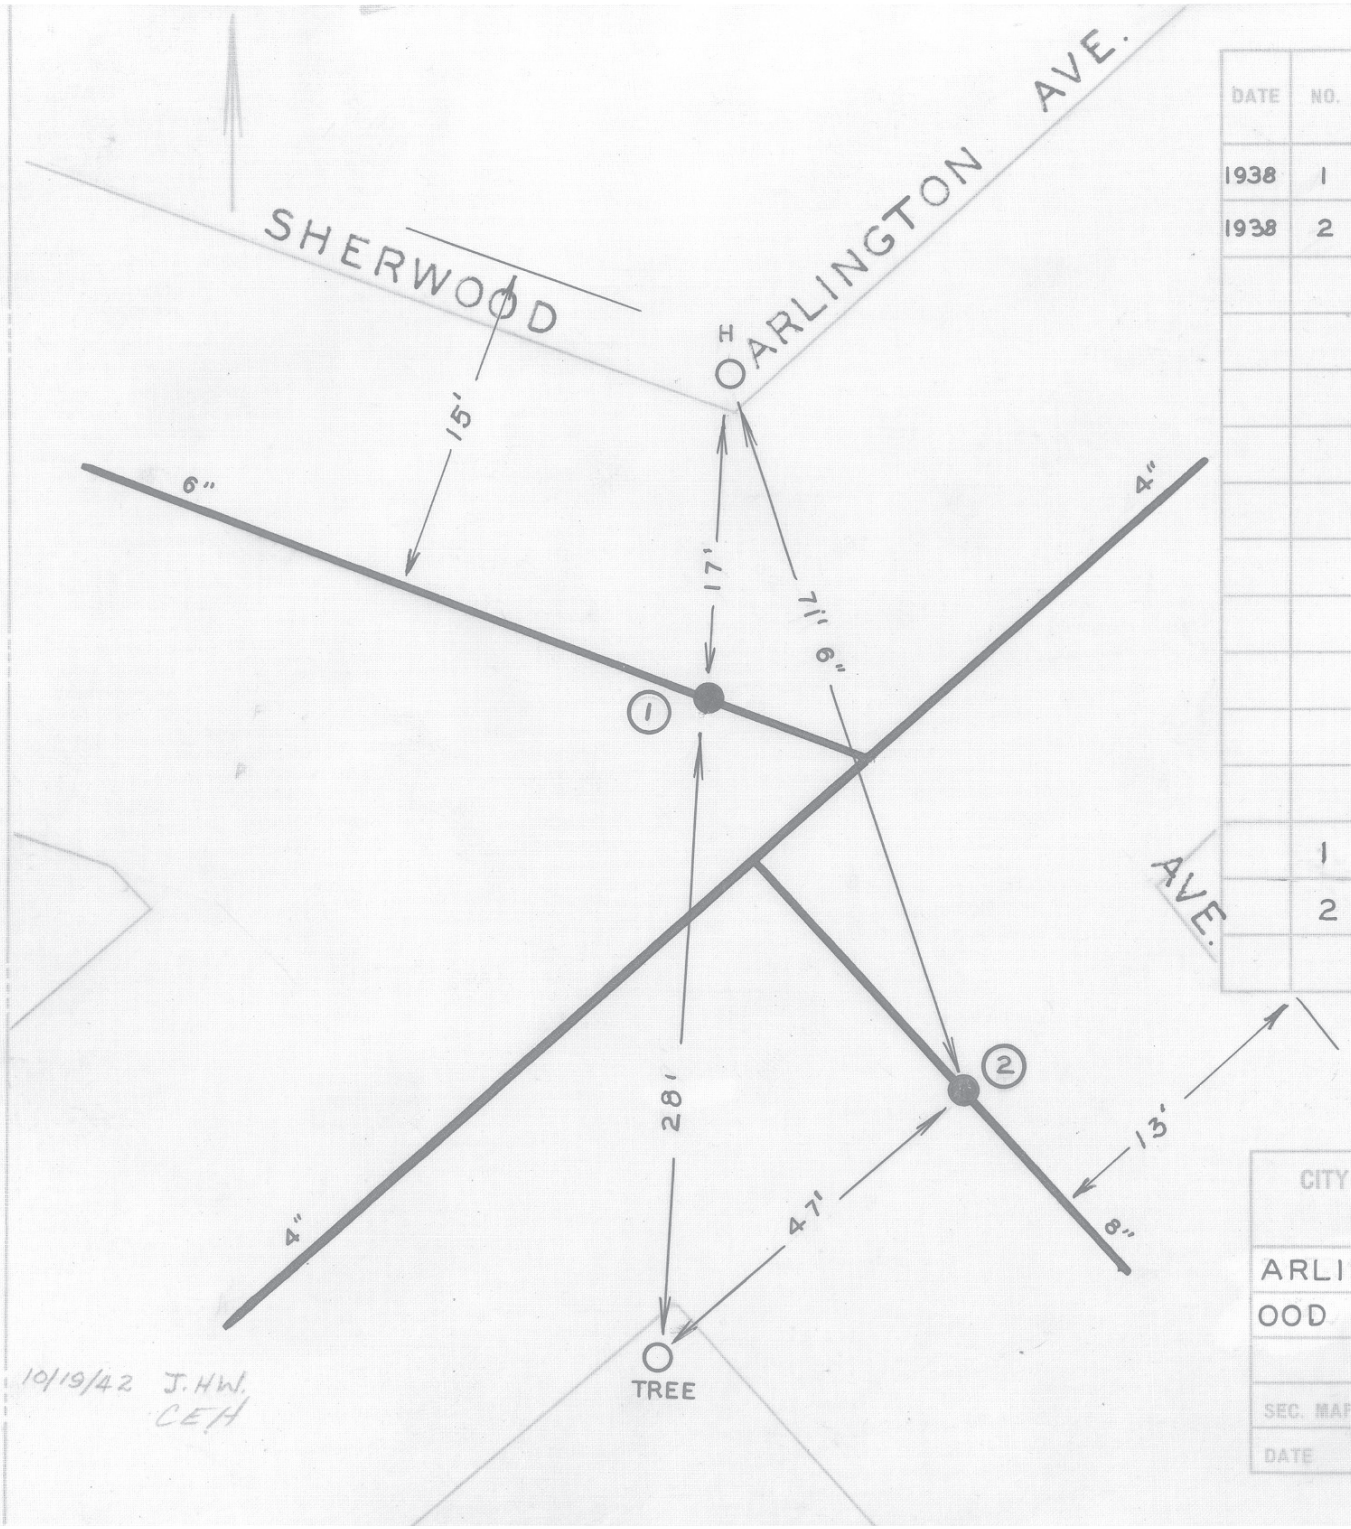

DATE	NO.	SIZE	MAKE	OPEN	TURNS
1938	1	6"		R	21
1938	2	8"		R	27 1/2
	1	14-S	SPL		
	2	5-S	SPL		

CITY OF ROANOKE—WATER DEP'T
VALVE DIAGRAM

ARLINGTON RD. & SHERWOOD AVE. S.W.

SEC. MAP 134

DATE PAGE NO. S.W. 382

10/19/42 J.H.W.
CEH