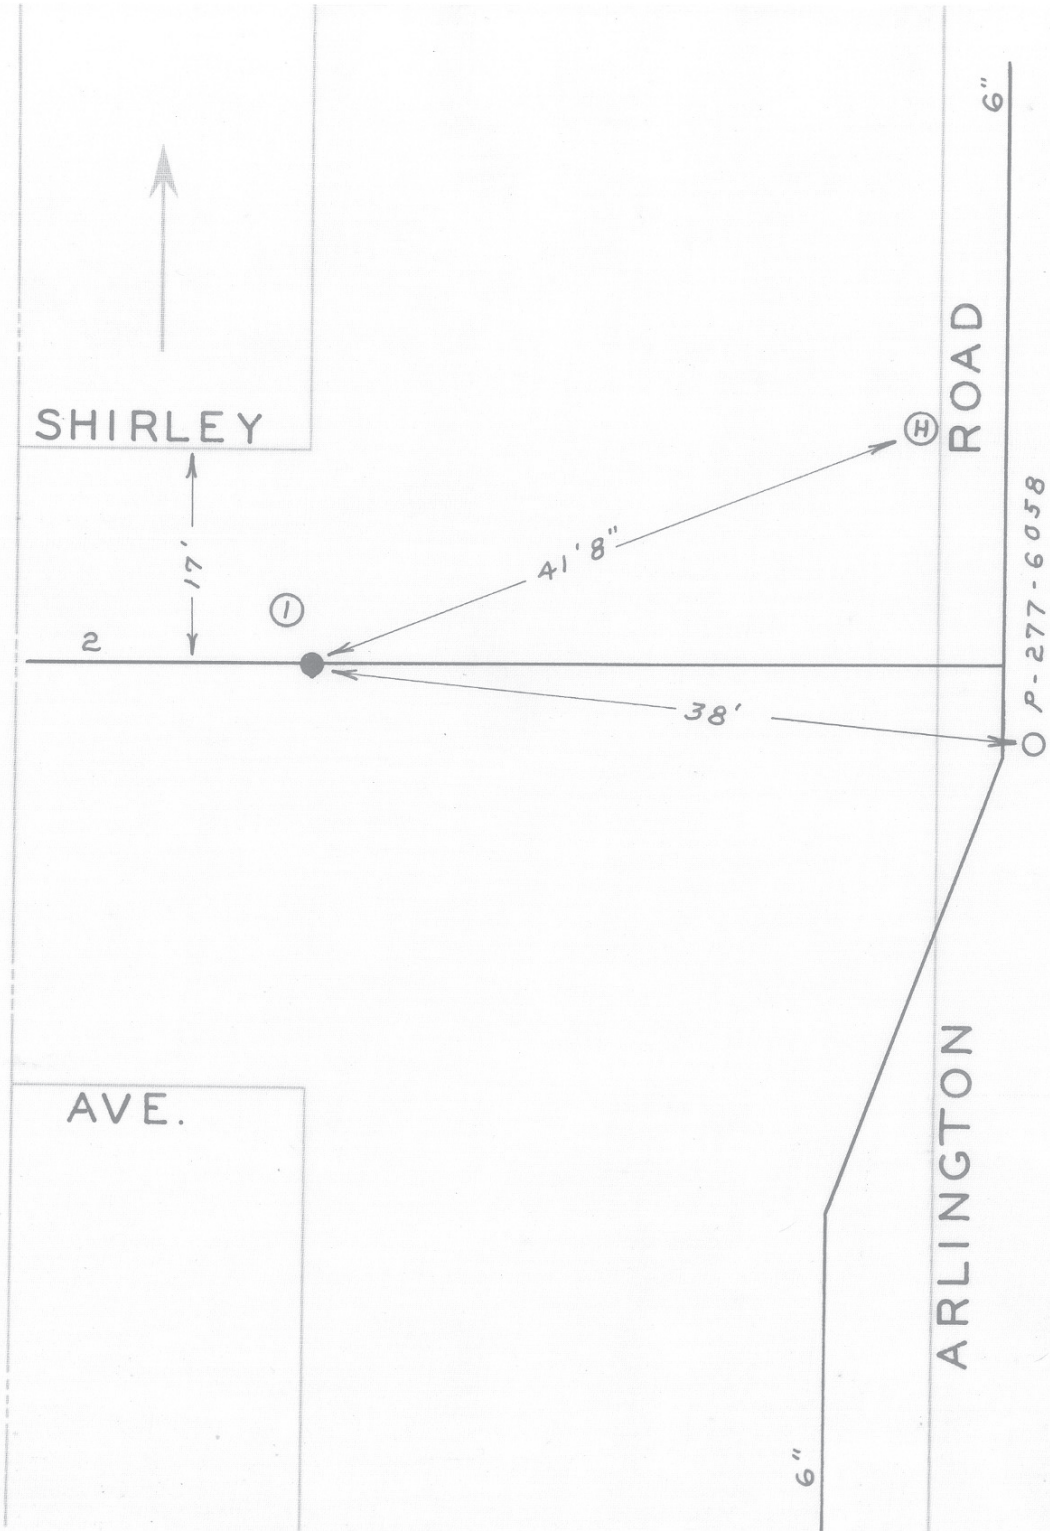

DATE	NO.	SIZE	MAKE	OPEN	TURNS
57	1	2"	DARLING	R	
	1	0	WPL		

CITY OF ROANOKE—WATER DEP'T

VALVE DIAGRAM

ARLINGTON RD. &

SHIRLEY AVE. S.W.

SEC. MAP 144

DATE PAGE NO.