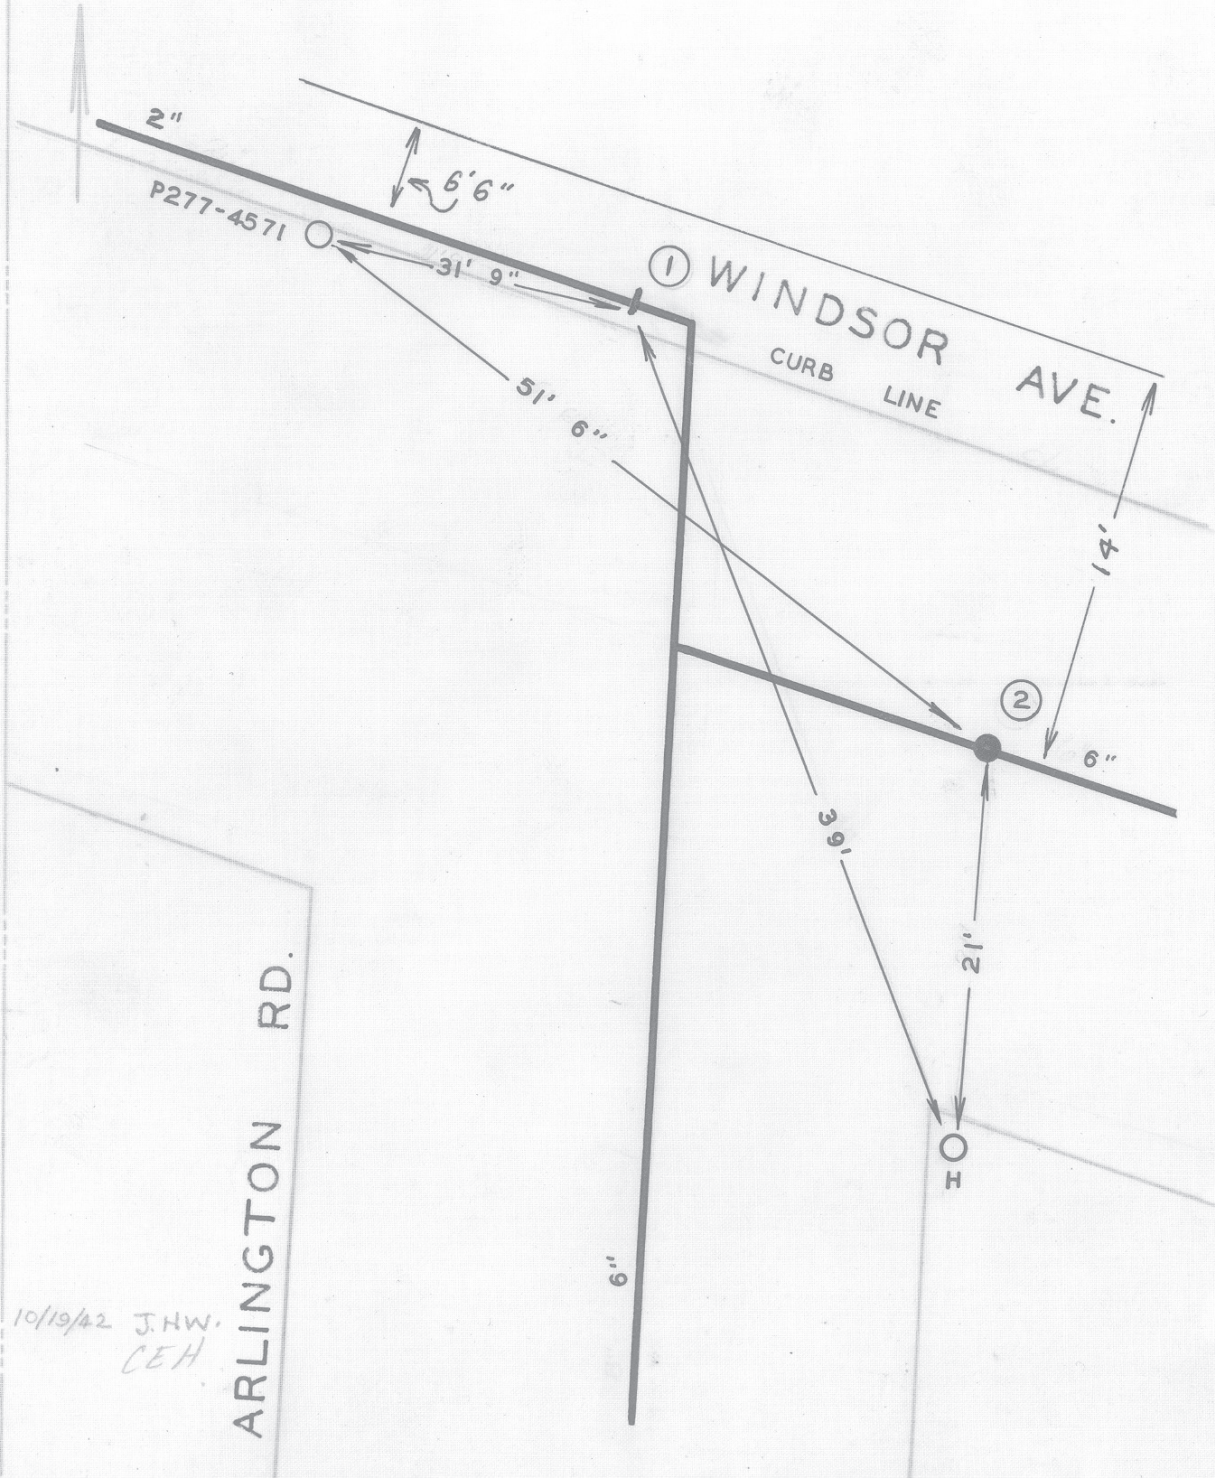

DATE	NO.	SIZE	MAKE	OPEN	TURNS
1924	1	2"		R	7
1927	2	6"		R	20 1/2
	1	41'-E	WPL		
	2	7'-E	EPL		

10/19/42 J.H.W.
CEH

CITY OF ROANOKE—WATER DEP'T
VALVE DIAGRAM

ARLINGTON RD & WINDSOR AVE. S. W.

SEC. MAP 134

DATE PAGE NO. S.W. 379