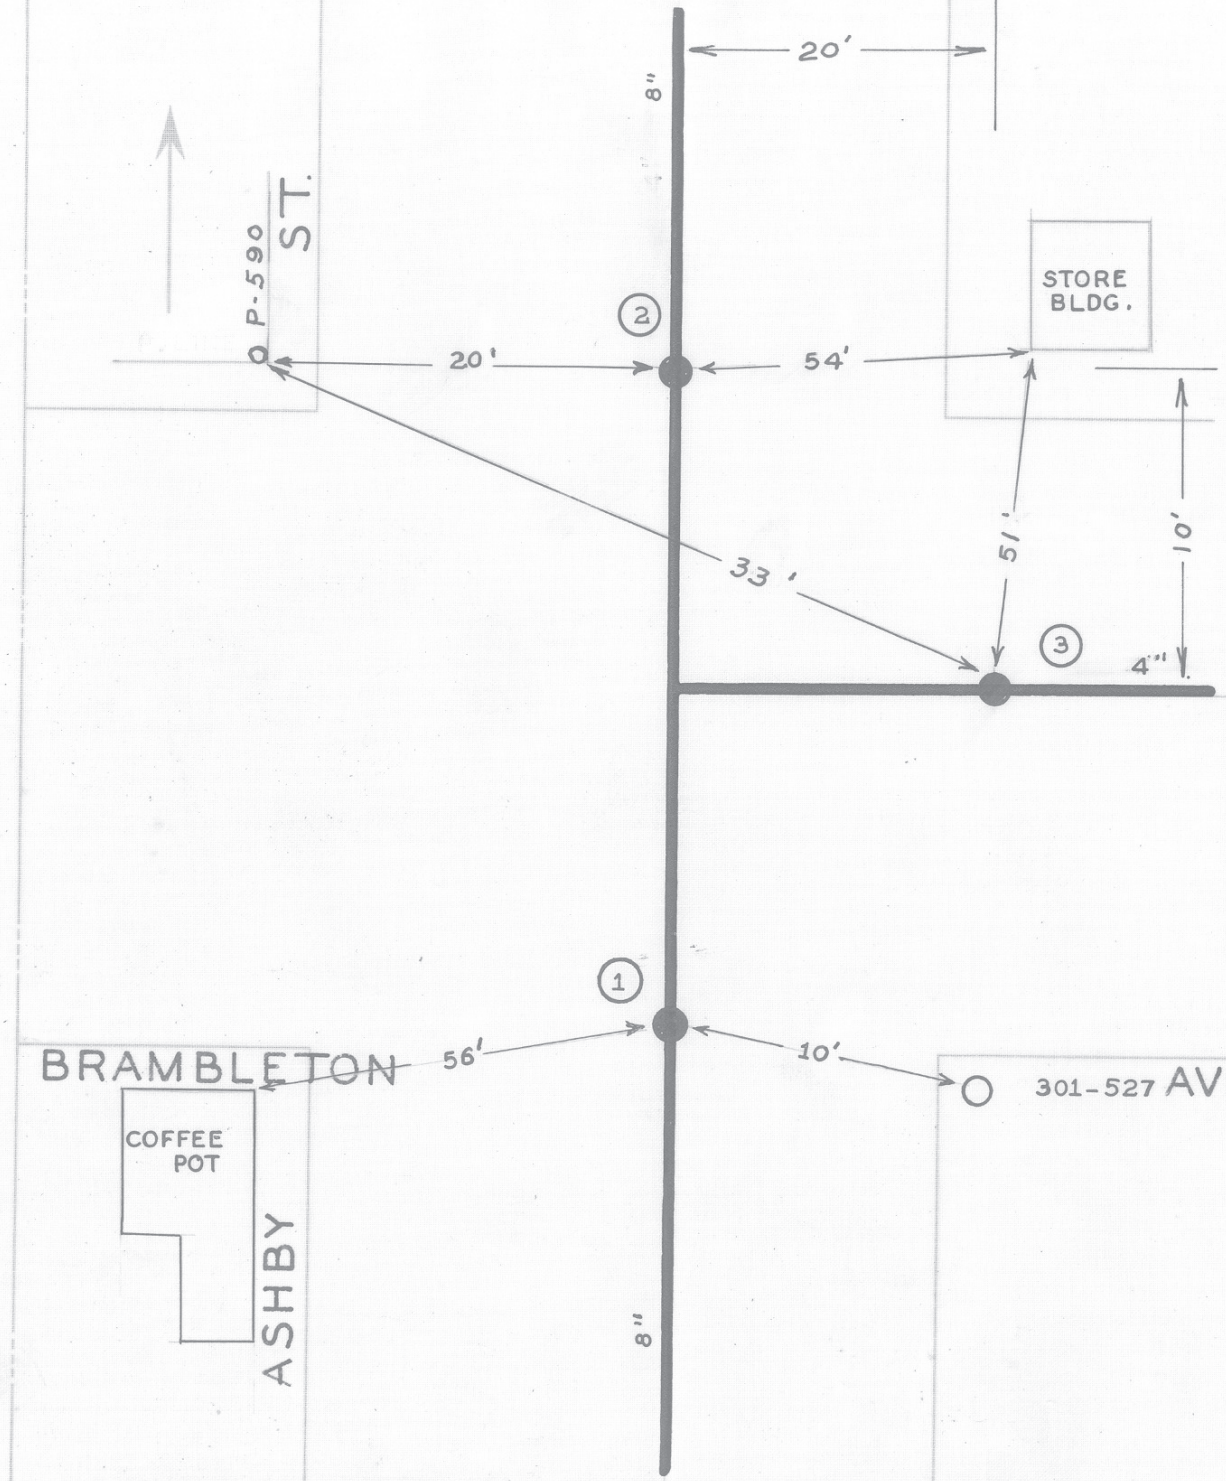

DATE	NO.	SIZE	MAKE	OPEN	TURNS
1948	1	8"	DARLING	R	27
1950	2	8"	DARLING	R	27
1950	3	4"	DARLING	R	14
	1	0	SPL		
	2	0	NPL		
	3	0	EPL		

CITY OF ROANOKE—WATER DEP'T

VALVE DIAGRAM

ASHBY ST. & BRAMBLETON AVENUE S.W.

SEC. MAP 157

DATE

PAGE NO. S.W.541