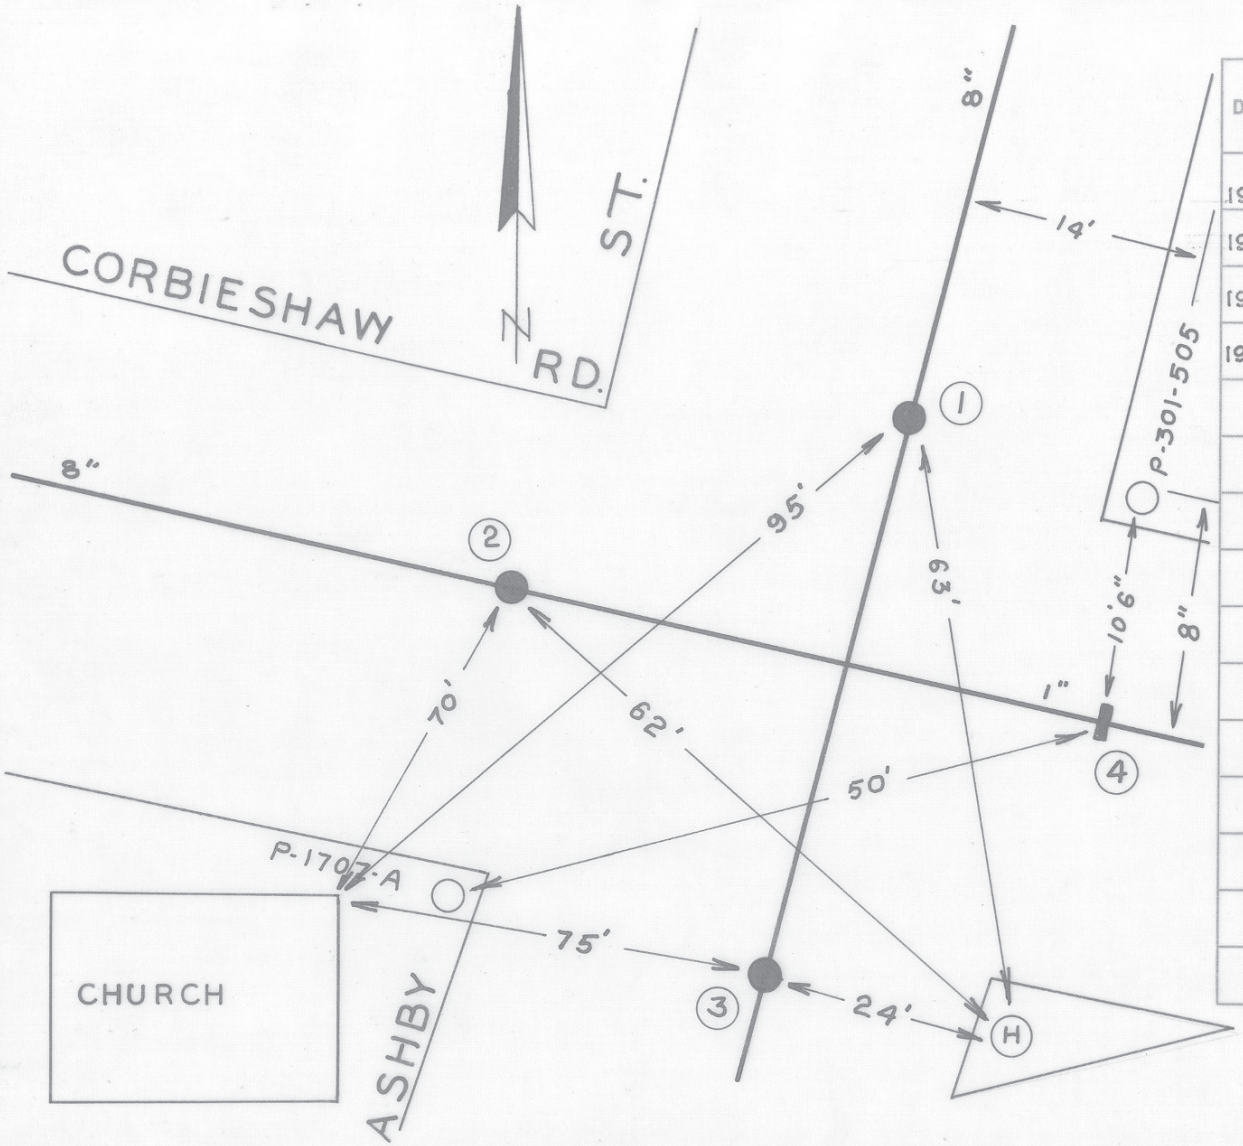

DATE	NO.	SIZE	MAKE	OPEN	TURNS
1950	1	8"	DARLING	R	27
1950	2	8"	DARLING	R	27
1950	3	8"	DARLING	R	27
1942	4	1"	CURB COCK		
	1	0	NPL		
	2	0	WPL		
	3	0	SPL		
	4	0	EPL		

CITY OF ROANOKE — WATER DEPT.

VALVE DIAGRAM

ASHBY ST. & CORBIESHAW ROAD S.W.

SEC. MAP 165

DATE PAGE NO.

"IMPERIAL" TRACING CLOTH
K & E CO., N. Y.