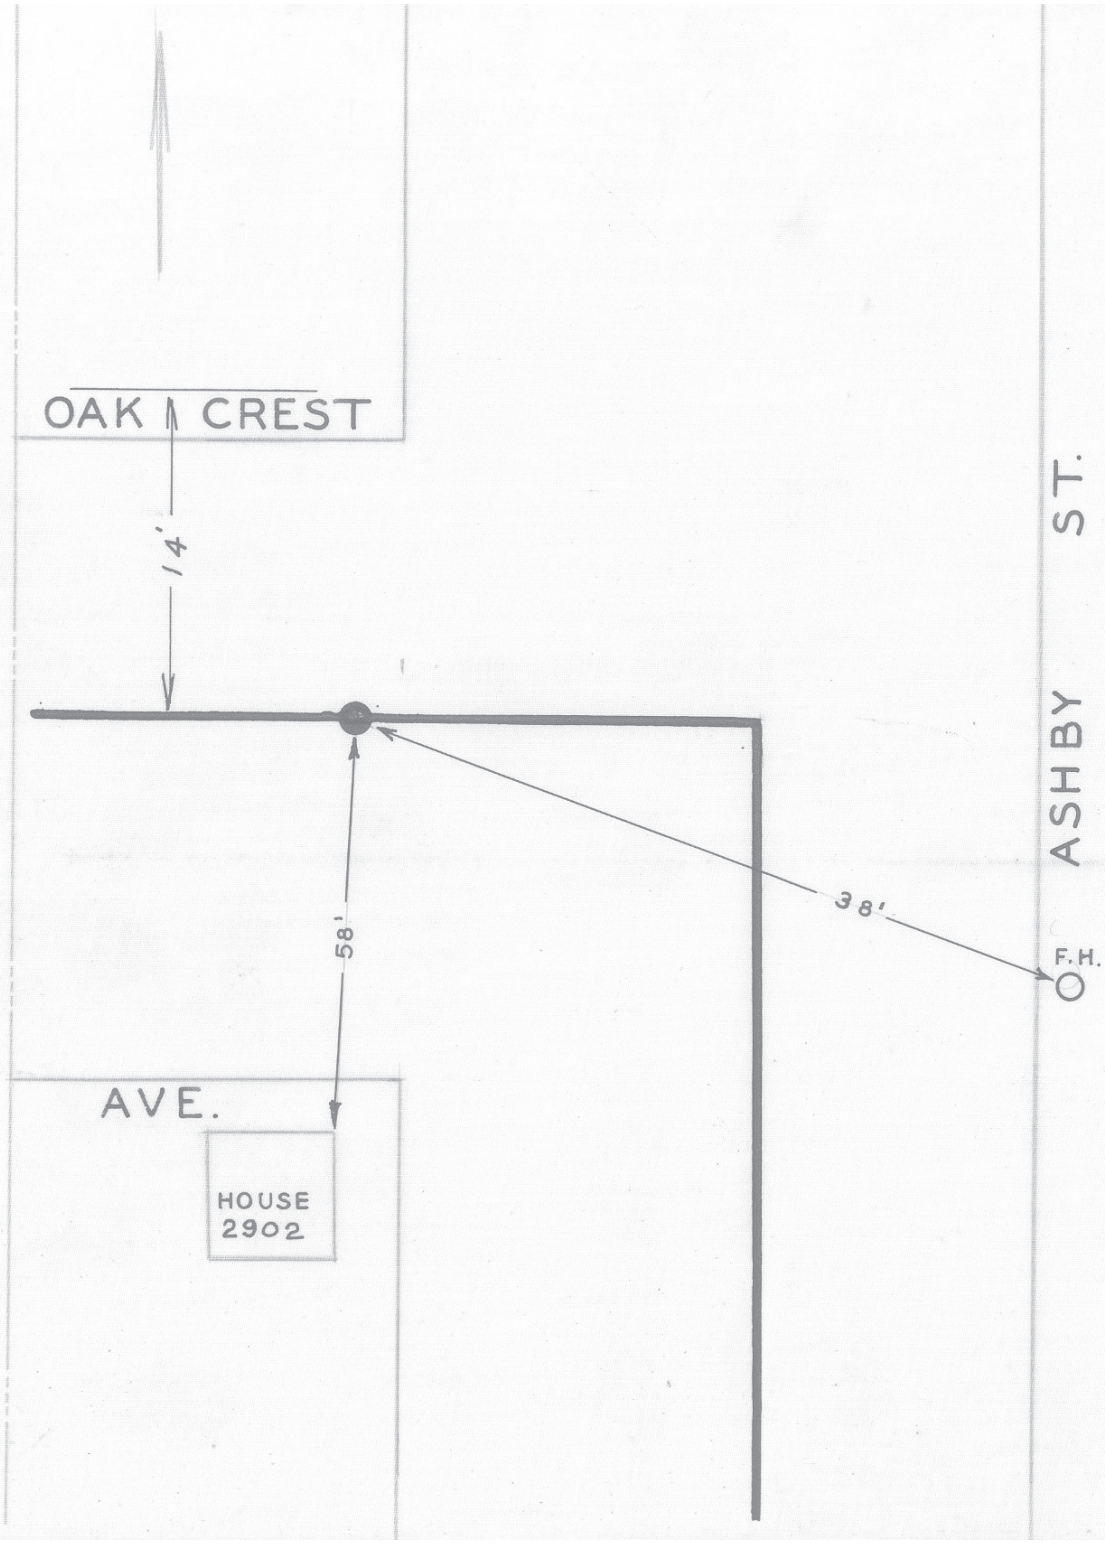

DATE	NO.	SIZE	MAKE	OPEN	TURNS
1950	1	6"	DARLING	R	21
	1	0	WPL		

CITY OF ROANOKE—WATER DEP'T

VALVE DIAGRAM

ASHBY STREET &

OAK CREST AVE. S.W.

SEC. MAP 165

DATE PAGE NO. SW583