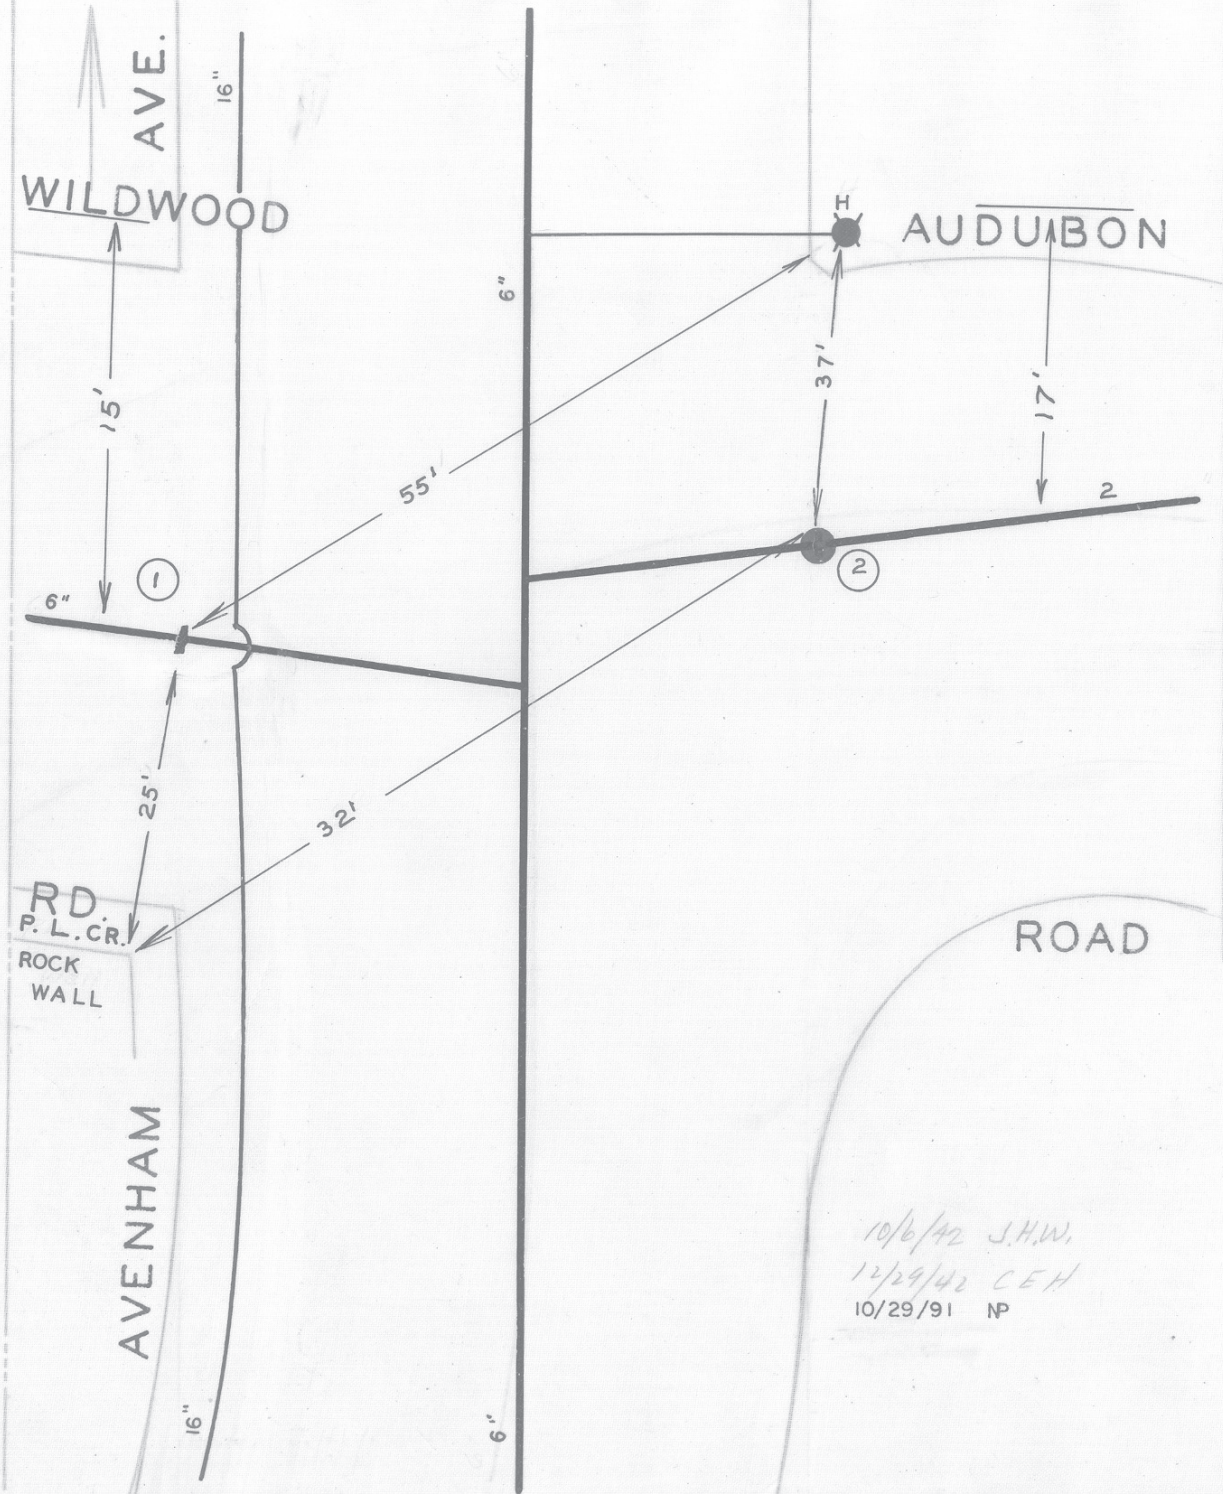

DATE	NO.	SIZE	MAKE	OPEN	TURNS
1928	1	6"		R	20 1/2
1925	2	2		R	8
	1	7'-W	WPL		
	2	19'-W	EPL		

CITY OF ROANOKE—WATER DEP'T

VALVE DIAGRAM

AUDUBON ROAD, WILDWOOD AVENUE, AVENHAM AVENUE, WILDWOOD ROAD

SEC. MAP 107 S.W.

DATE PAGE NO. S.W. 286