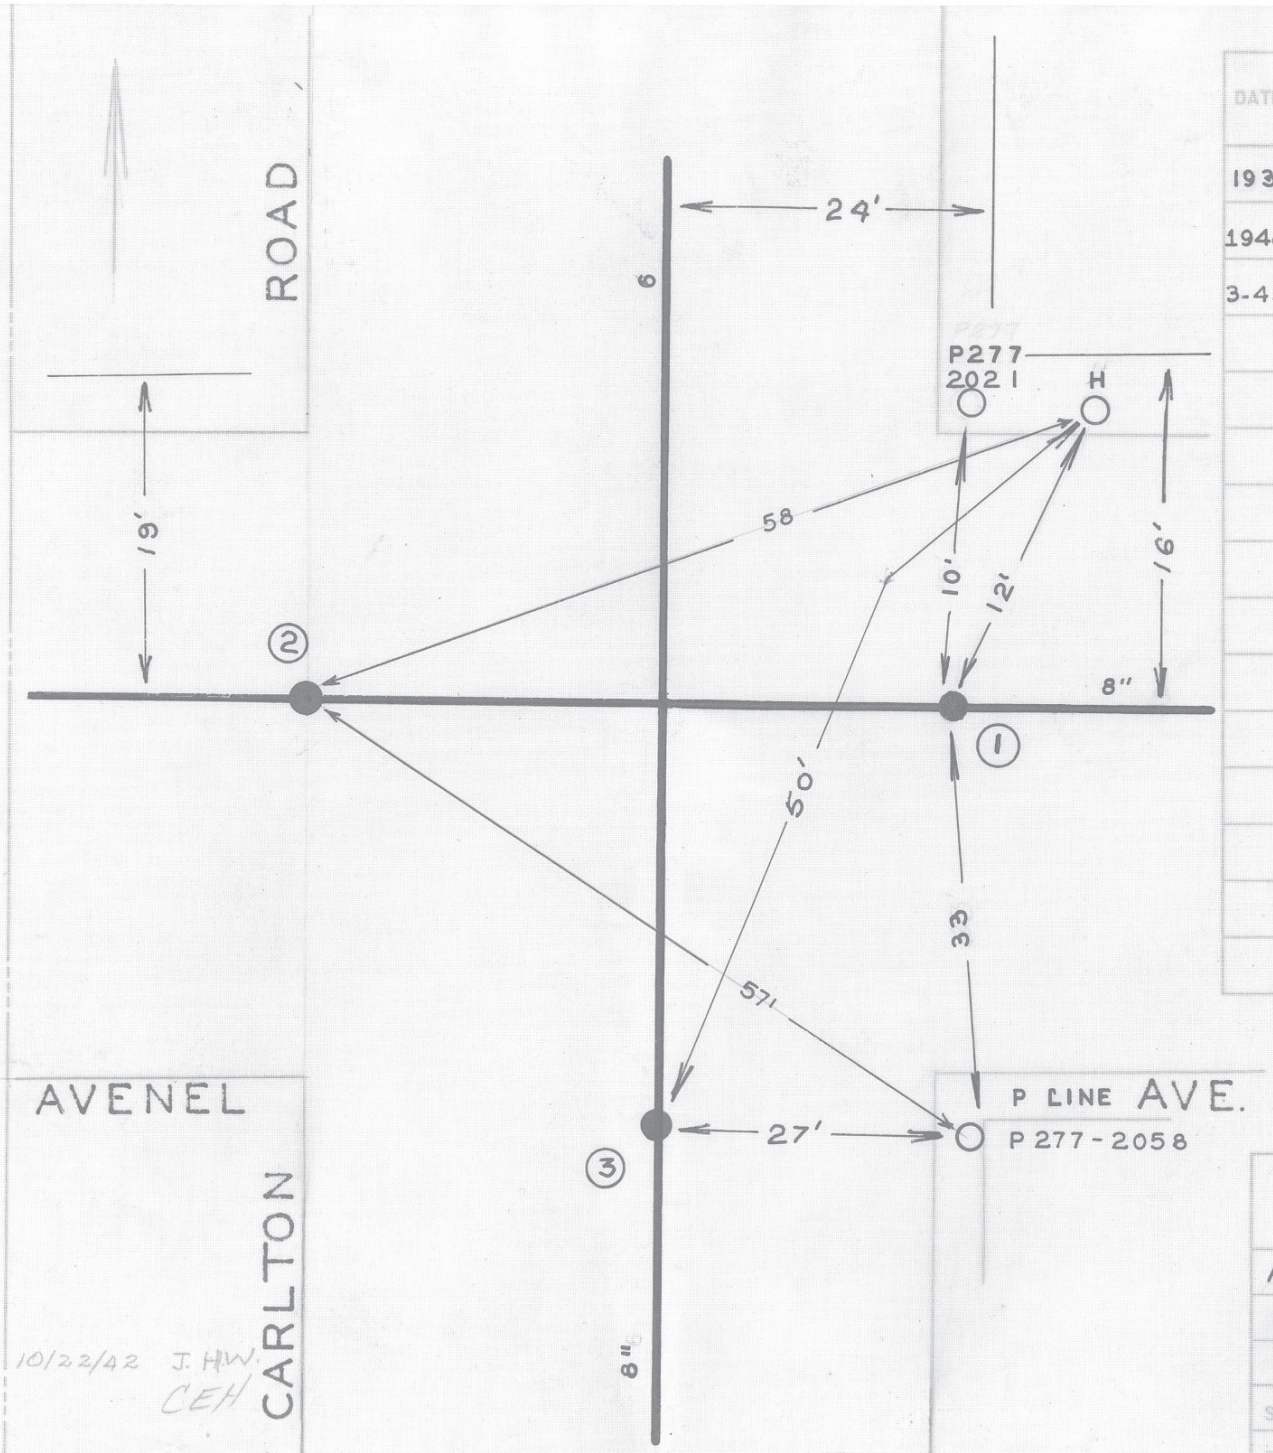

DATE	NO.	SIZE	MAKE	OPEN	TURNS
1933	1	8"		R	26 1/2
1948	2	2"	DARLING	R	7
3-45	3	8"	DARLING	R	27
	1	0	EPL		
	2	0	WPL		
	3	0	SPL		

10/22/42 J. HW
CEH

CITY OF ROANOKE—WATER DEP'T
VALVE DIAGRAM

AVENEL AVE. & CARLTON ROAD S. W.

SEC. MAP 154

DATE PAGE NO. S.W.449