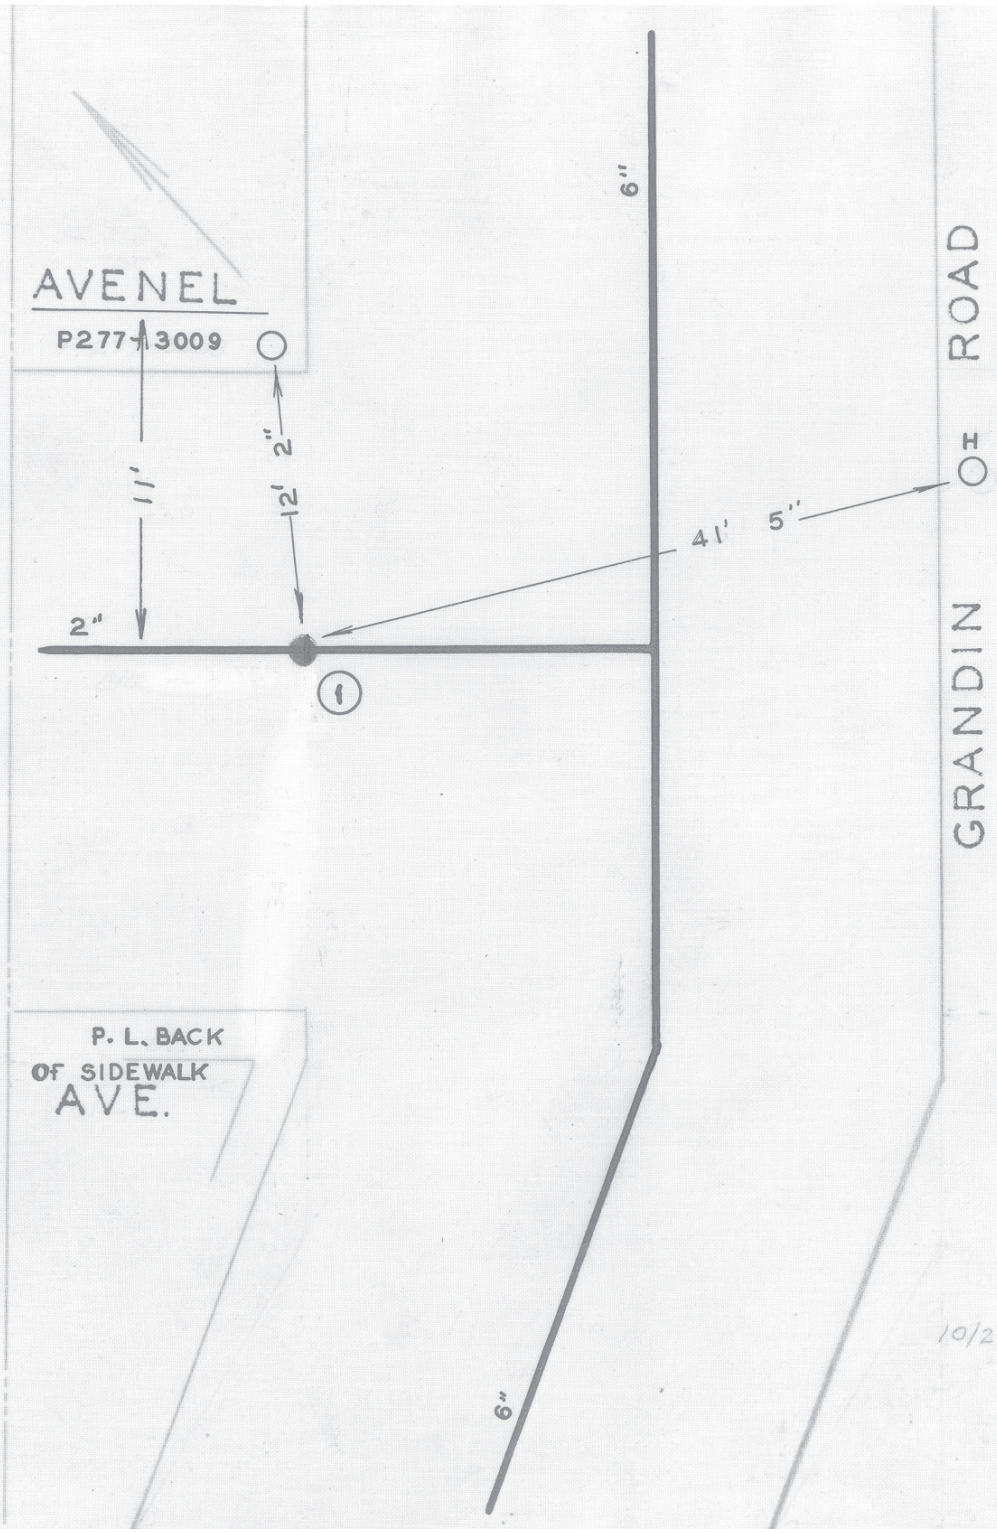

DATE	NO.	SIZE	MAKE	OPEN	TURNS
1920	1	2"		R	7
	1	8'-E	WPL		

10/22/42 [illegible]
CEH

CITY OF ROANOKE—WATER DEP'T
VALVE DIAGRAM

AVENEL AVE. & GRANDIN RD. S. W.

SEC. MAP 154

DATE PAGE NO. S.W.452