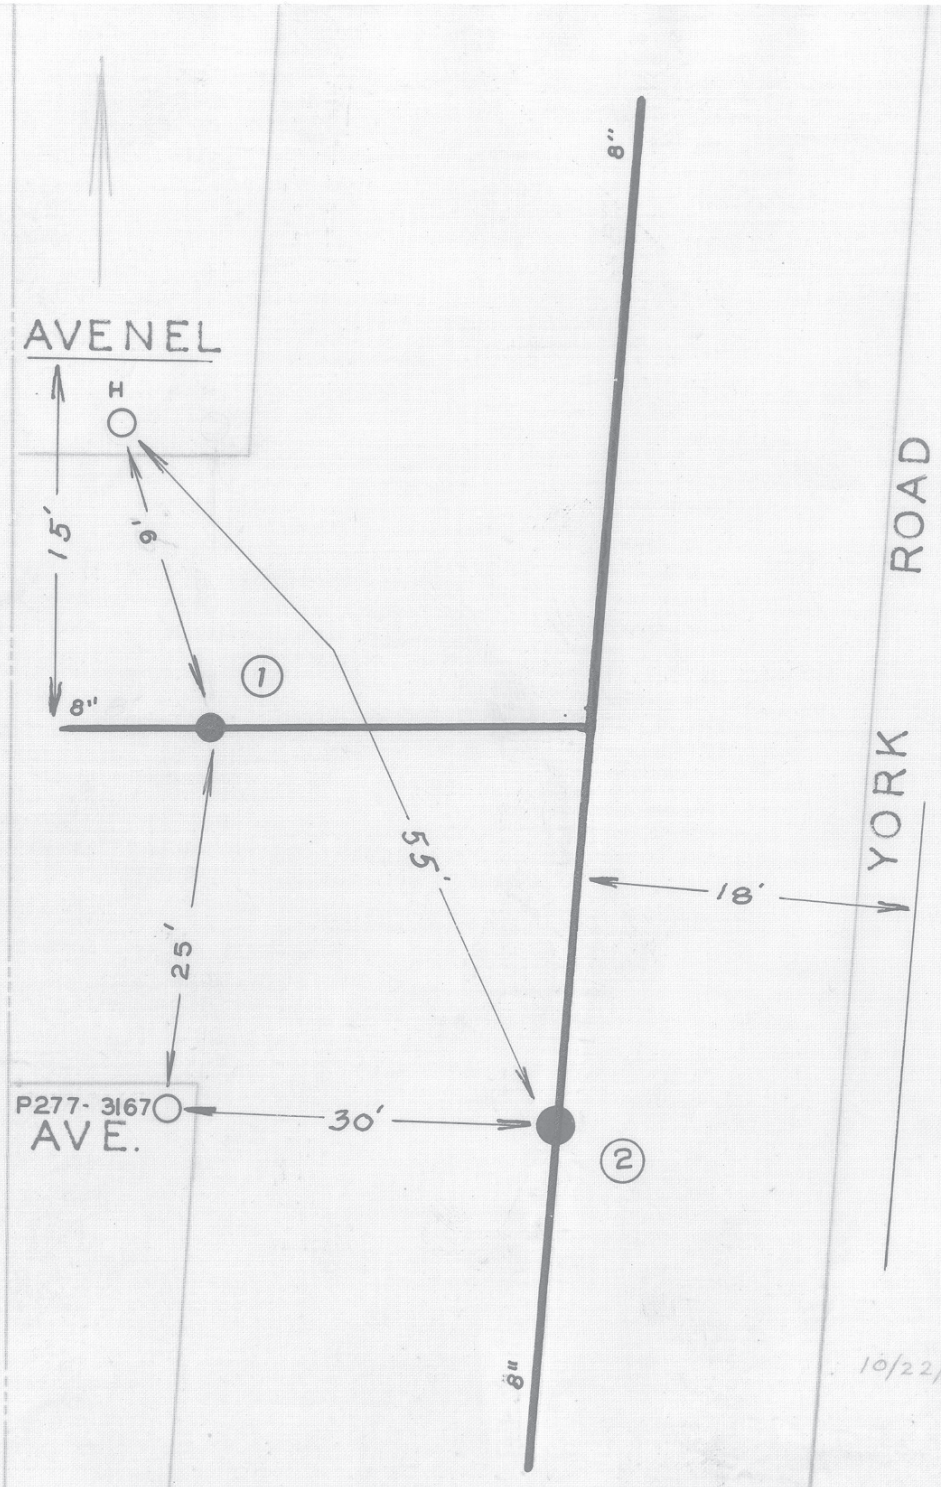

DATE	NO.	SIZE	MAKE	OPEN	TURNS
1933	1	8"		R	26
8-45	2	8"			
	1	0	WPL		
	2	0	SPL		

10/22/42 J.H.W.

CITY OF ROANOKE—WATER DEP'T

VALVE DIAGRAM

AVENEL AVE. & YORK ROAD LEE HY COURT

SEC. MAP 154

DATE

PAGE NO. S.W.450