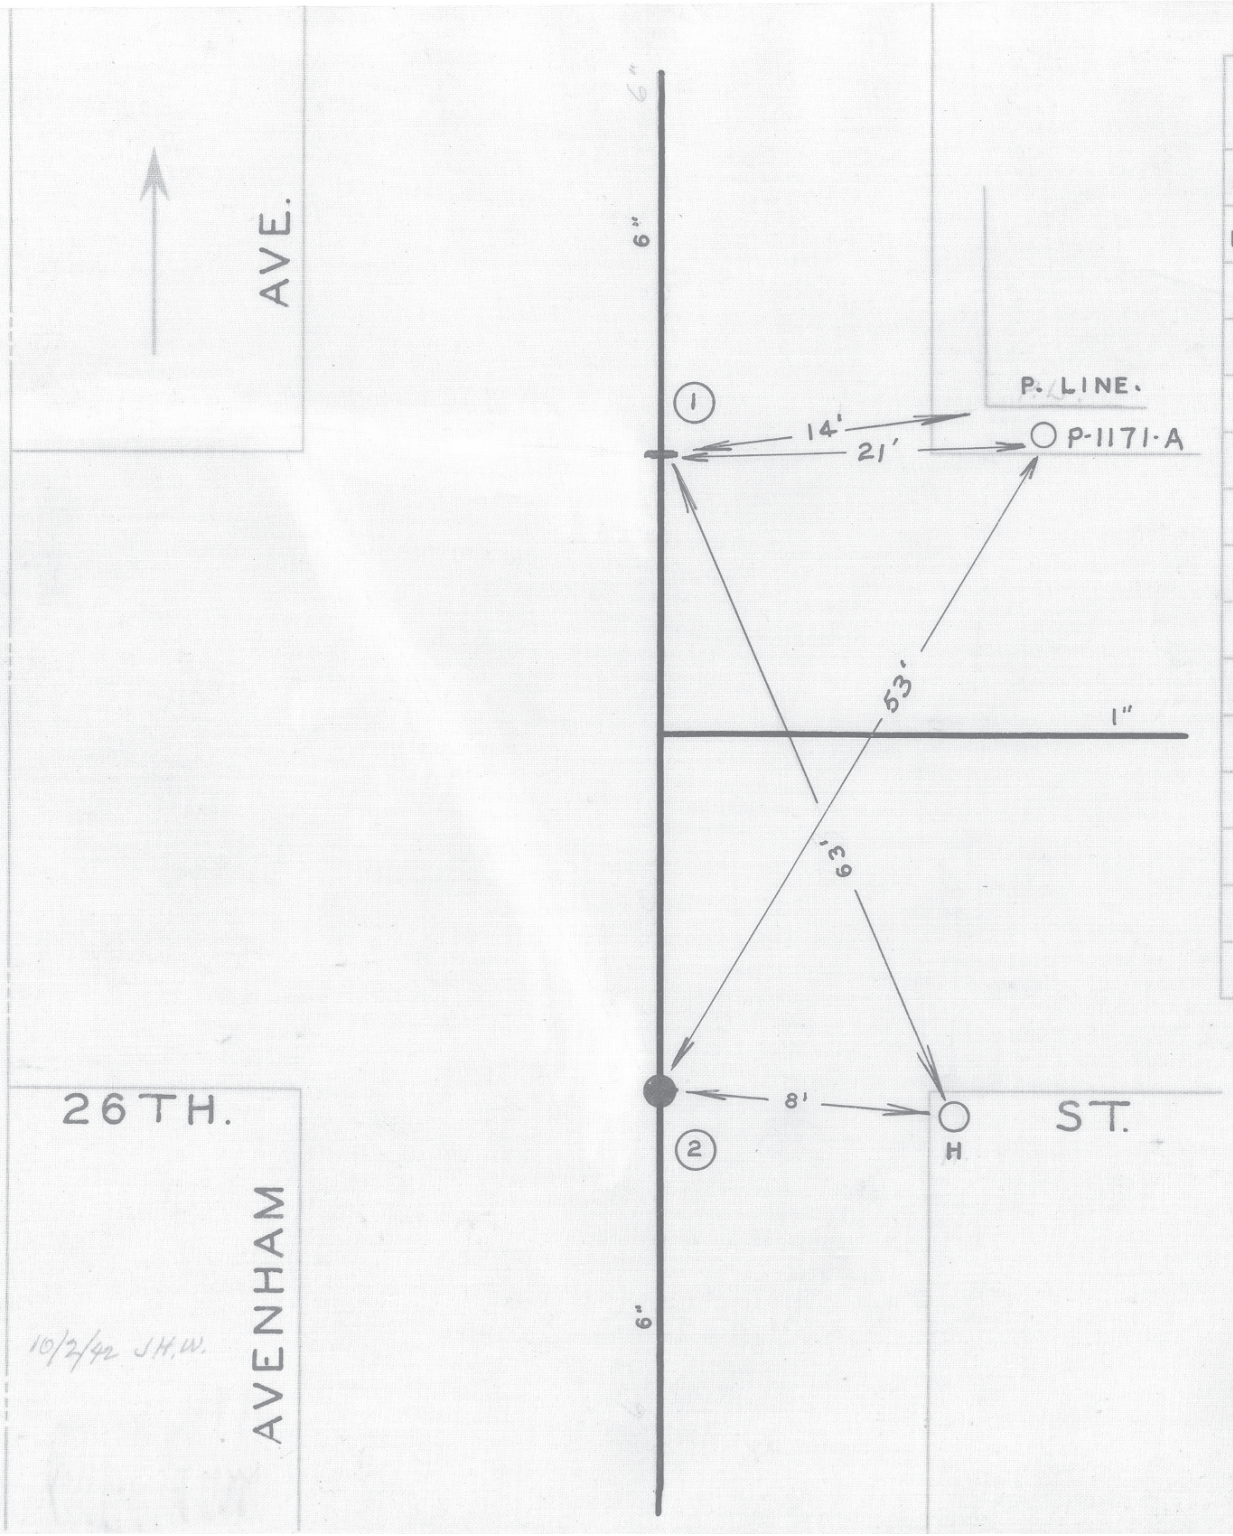

DATE	NO.	SIZE	MAKE	OPEN	TURNS
1891	1	6"		R	20 1/2
1891	2	6"		R	20 1/2
	1	0	NPL		
	2	0	SPL		

CITY OF ROANOKE—WATER DEP'T

VALVE DIAGRAM

AVENHAM AVE. & 26TH. ST. SOUTH WEST

SEC. MAP 106

DATE PAGE NO. S.W. 265