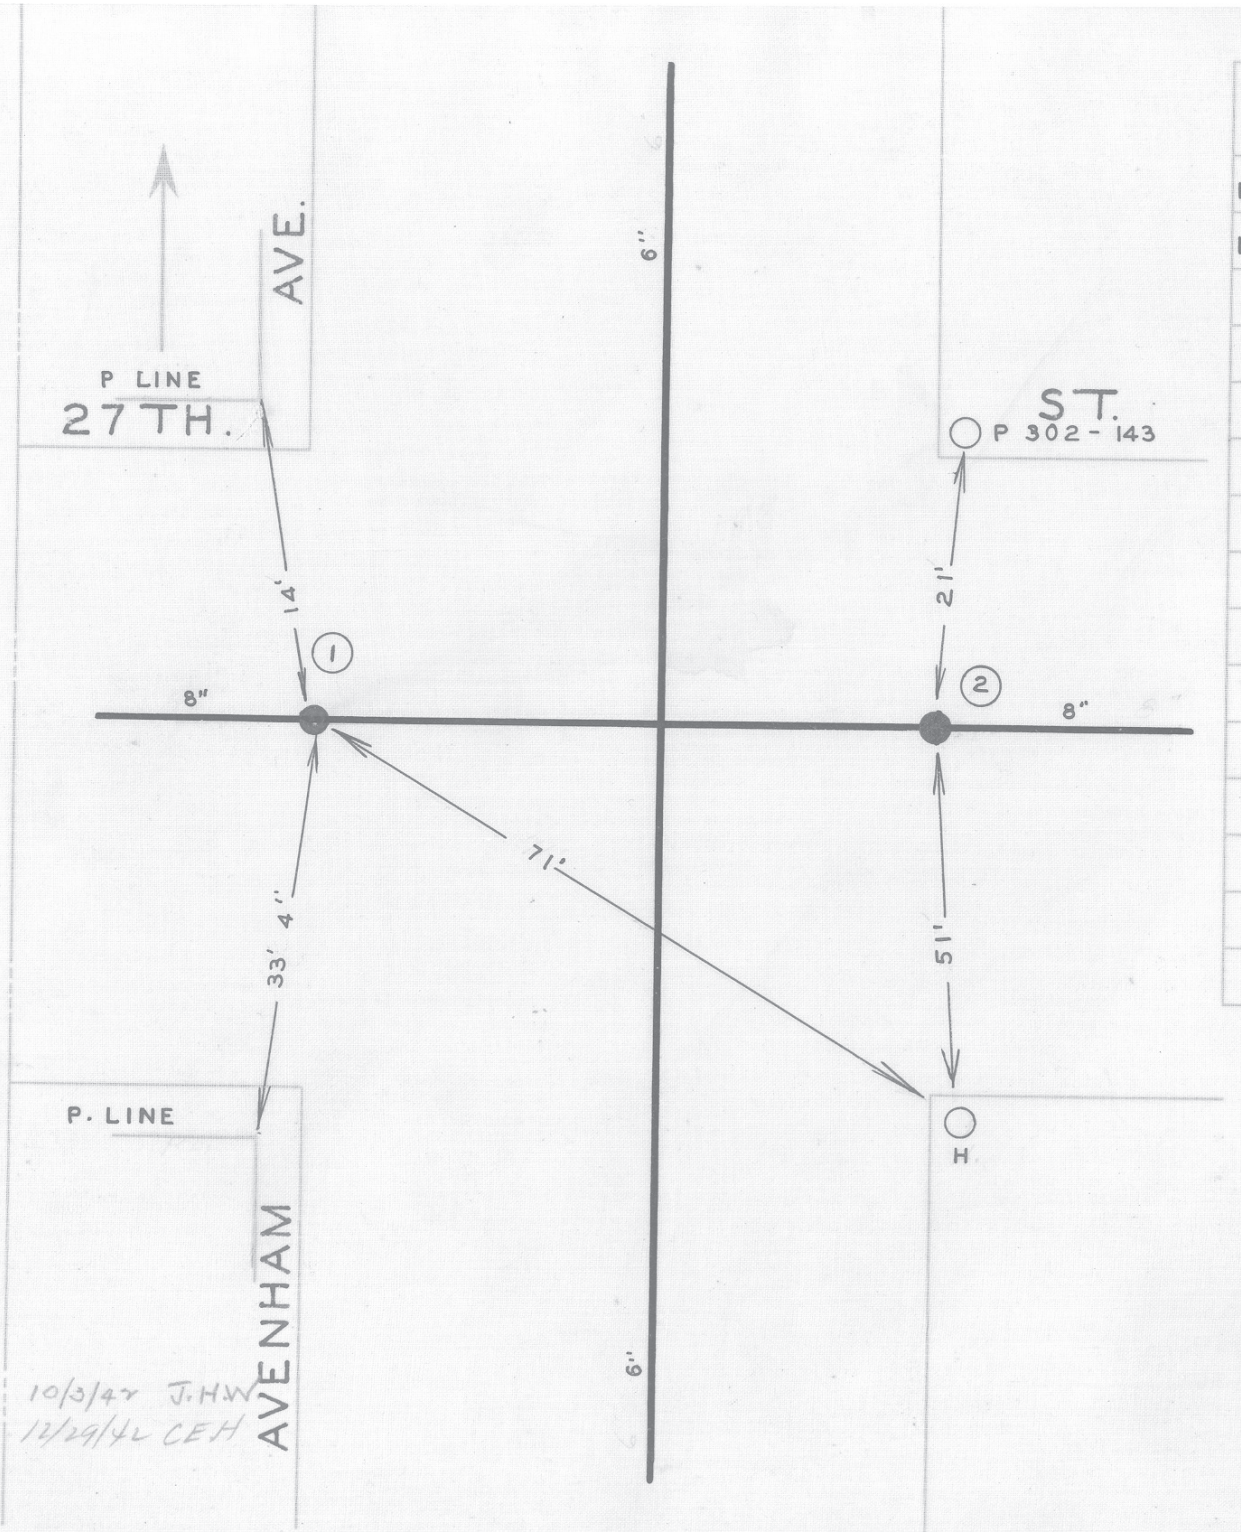

DATE	NO.	SIZE	MAKE	OPEN	TURNS
1939	1	8"		R	27 1/2
1924	2	8"		L	27 1/2
	1	0	WPL		
	2	0	EPL		

CITY OF ROANOKE—WATER DEP'T

VALVE DIAGRAM

AVENHAM AVE. & 27TH. ST. SOUTH WEST

SEC. MAP 106

DATE

PAGE NO. S.W.266