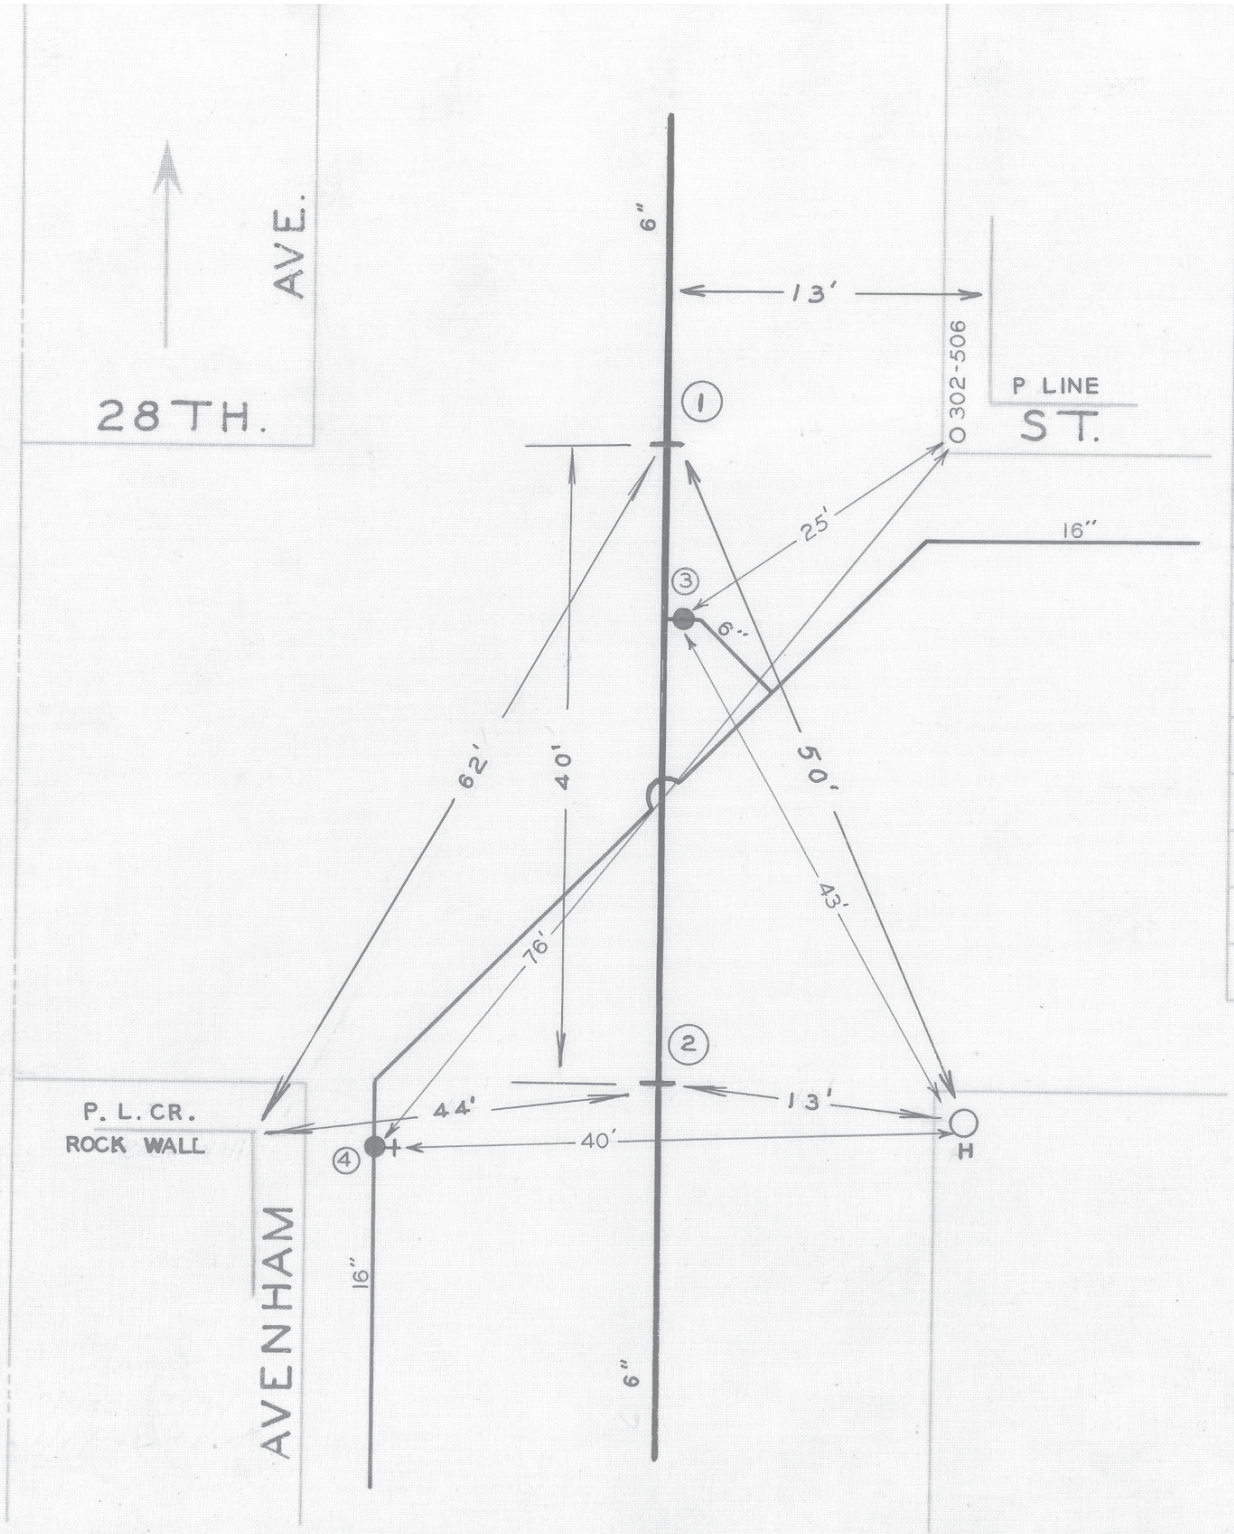

DATE	NO.	SIZE	MAKE	OPEN	TURNS
1891	1	6"		R	12 1/2
1912	2	6"		R	13
73	3	6"	DARLING	R	
73	4	16"	MUELLER	R	
	1	5'-S	NPL		
	2	6'-N	SPL		

CITY OF ROANOKE—WATER DEP'T

VALVE DIAGRAM

AVENHAM AVE. & 28TH. ST. SOUTH WEST

SEC. MAP 106

DATE

PAGE NO. S.W. 267