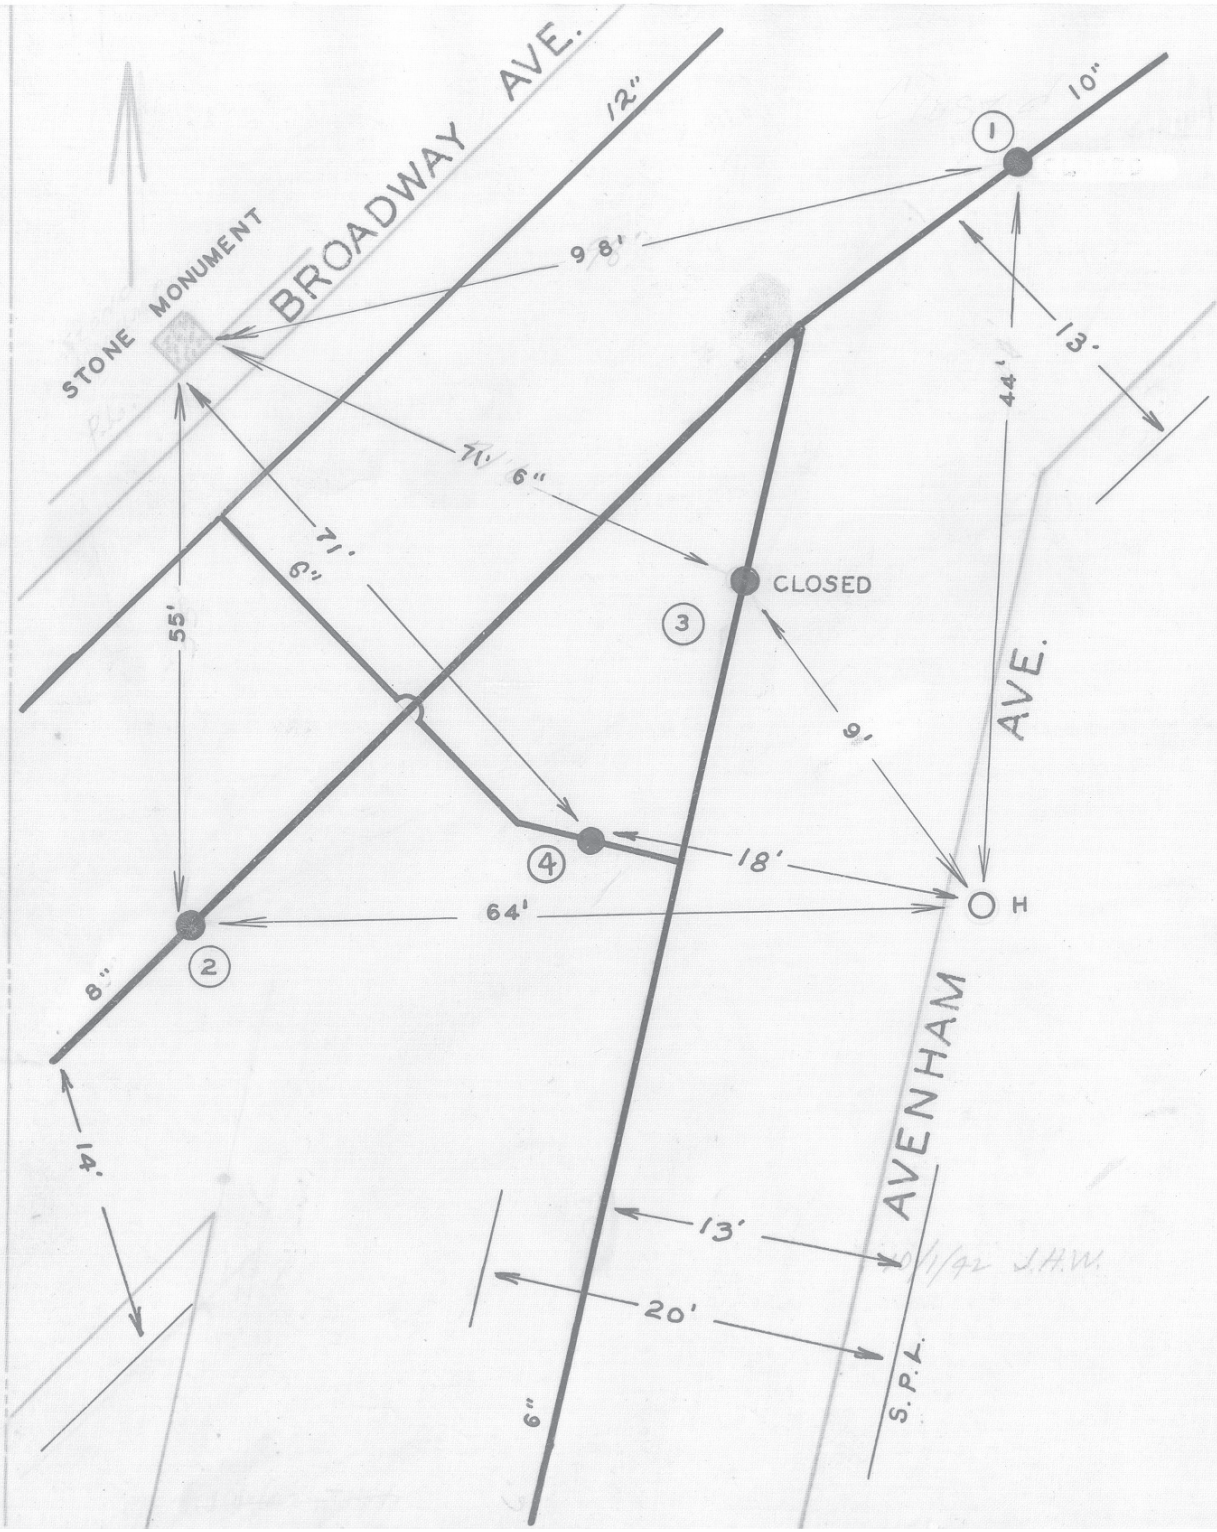

DATE	NO.	SIZE	MAKE	OPEN	TURNS
1891	1	10"		R	33
1940	2	8"		R	26 1/2
1891	3	6"		R	20 1/2
1953	4	6"	MUELLER	R	20
	1	17'-W	SPL		
	2	4'-W	WPL		
	3	9'-W	EPL		
	4	0	EPL		

CITY OF ROANOKE—WATER DEP'T

VALVE DIAGRAM

AVENHAM AVE. & BROADWAY AVE. S. W.

SEC. MAP 105

DATE PAGE NO. S.W.263