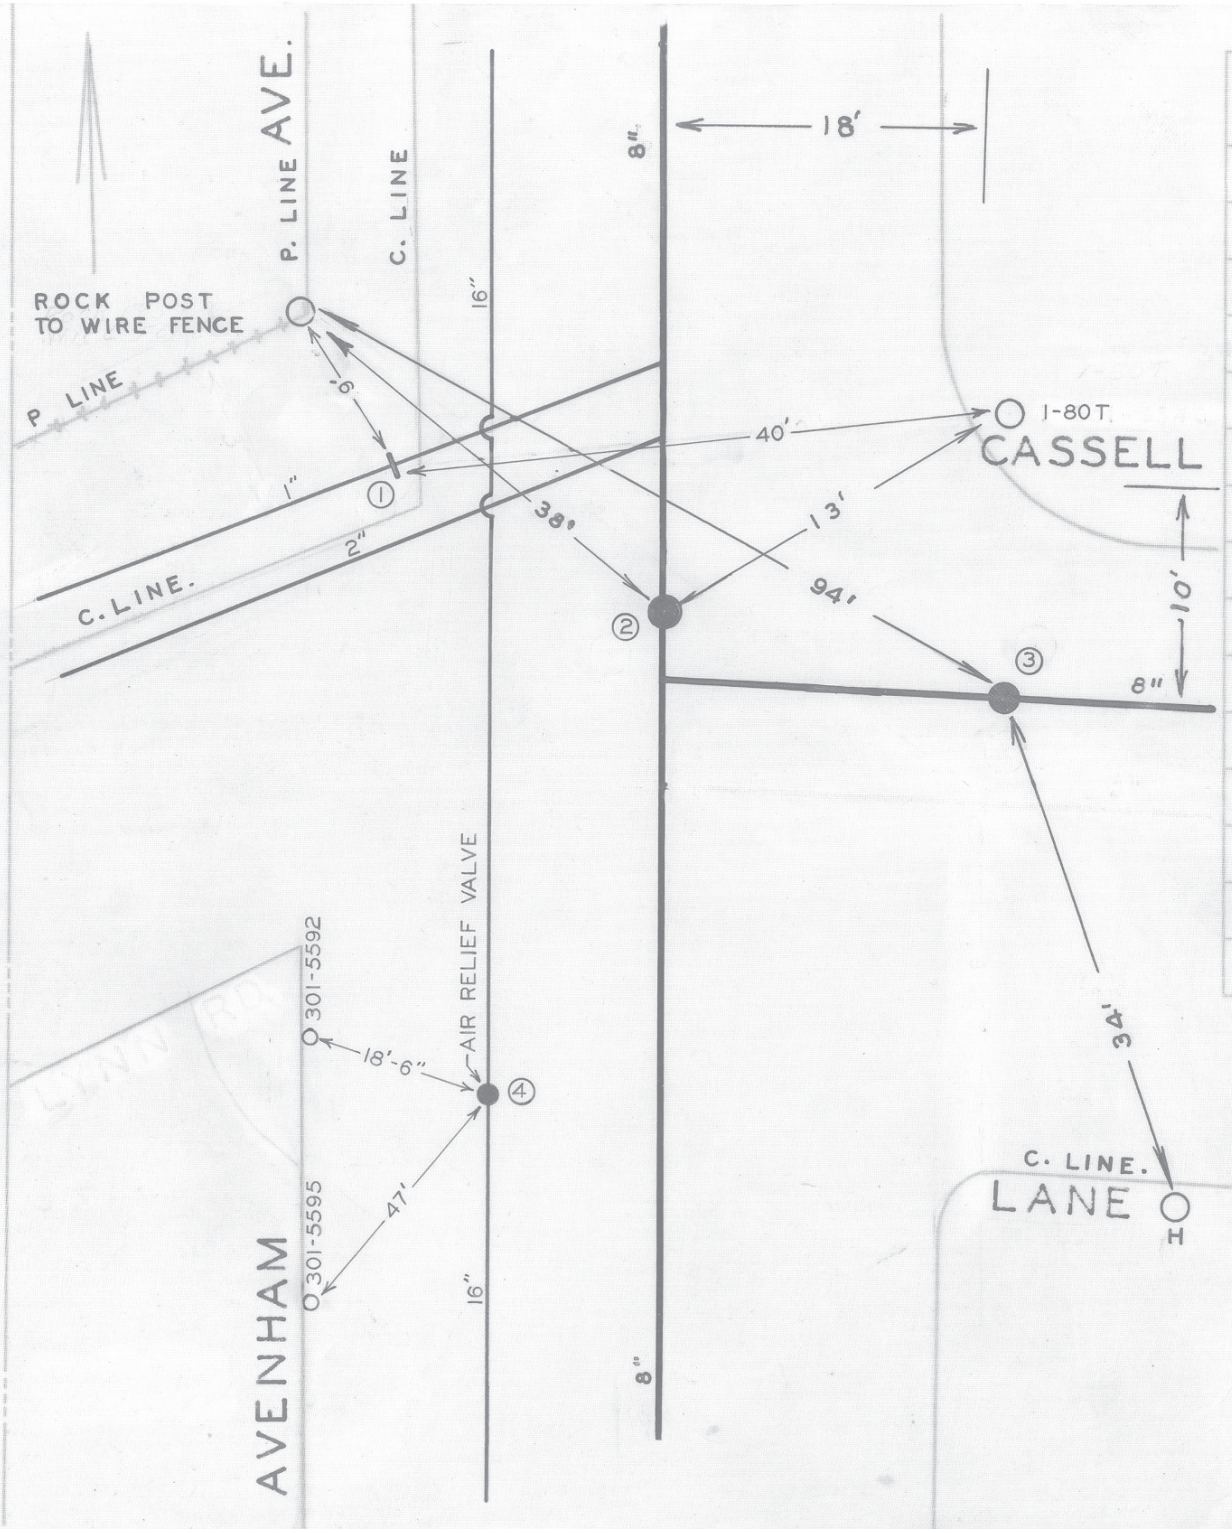

DATE	NO.	SIZE	MAKE	OPEN	TURNS
25	1	1"	CURB COCK		
26	2	6"	ABANDONED	R	20 ½
45	3	8"	DARLING	R	27 ½
73	4	1"	CURB COCK		27½
	1	6	NPL		
	2		ABANDONED		
	3	5	NPL		
	4	6	NPL		

CITY OF ROANOKE—WATER DEP'T

VALVE DIAGRAM

AVENHAM AVENUE &

CASSELL LANE S.W.

SEC. MAP 107

DATE PAGE NO.