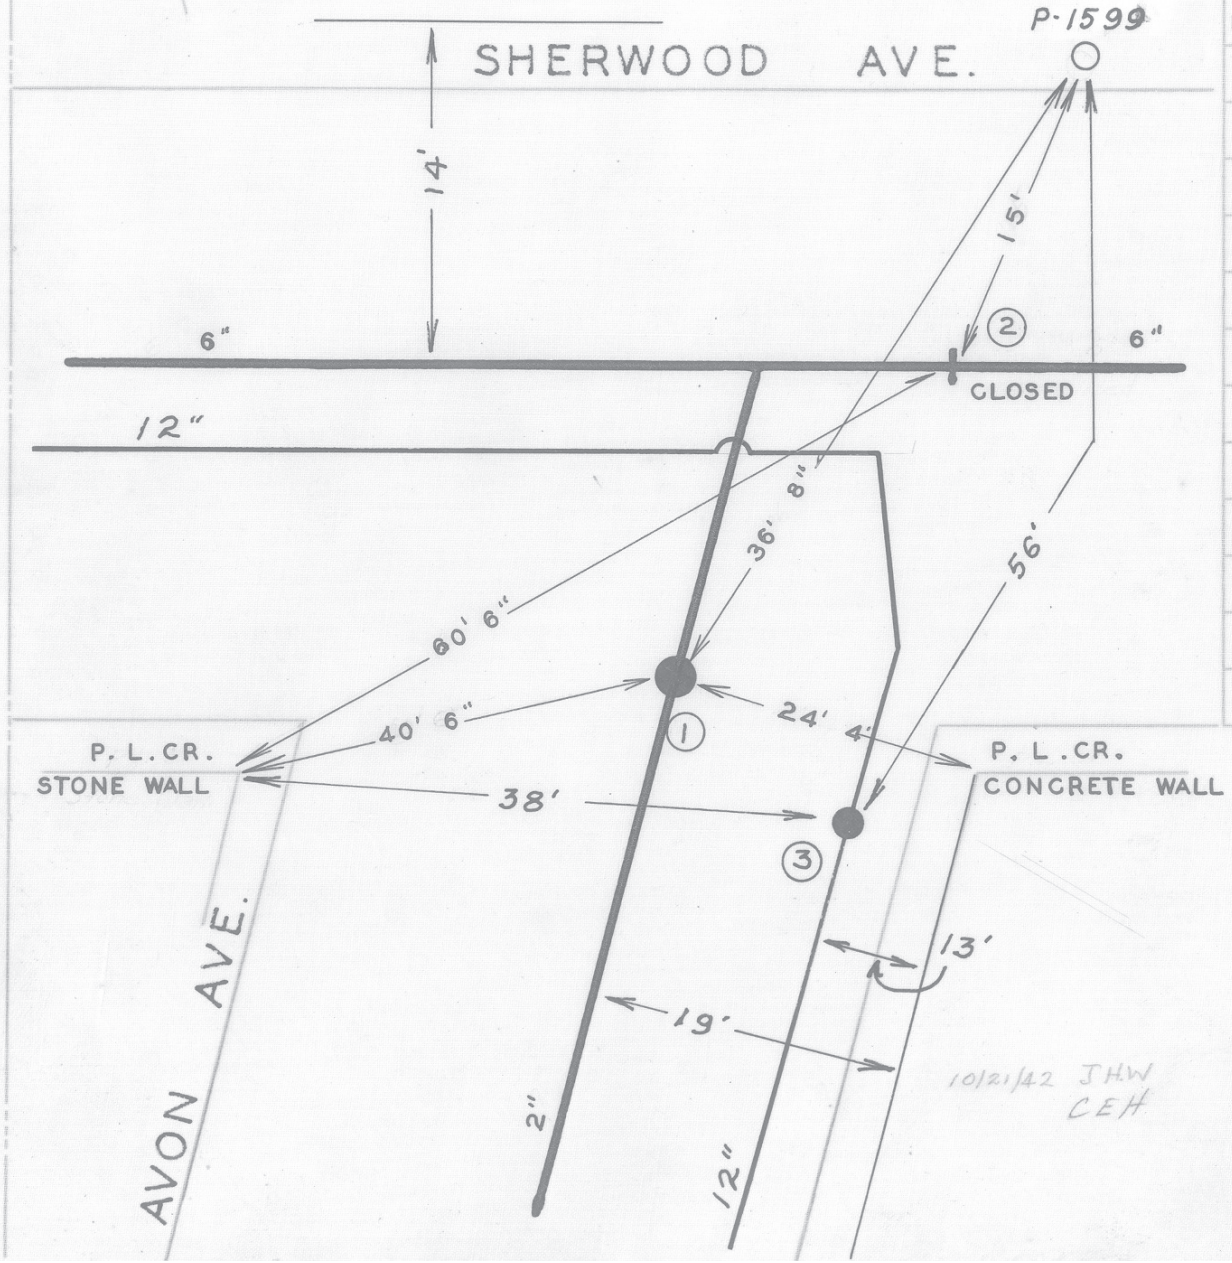

DATE	NO.	SIZE	MAKE	OPEN	TURNS
1924	1	2"		R	7
1922	2	6"		R	21
1953	3	12"			
	1	19'-N	SPL		
	2	20'-W	EPL		
	3	4'-S	SPL		

CITY OF ROANOKE—WATER DEP'T

VALVE DIAGRAM

AVON AVE. & SHERWOOD AVE. S. W.

SEC. MAP 144

DATE

PAGE NO. S.W.427