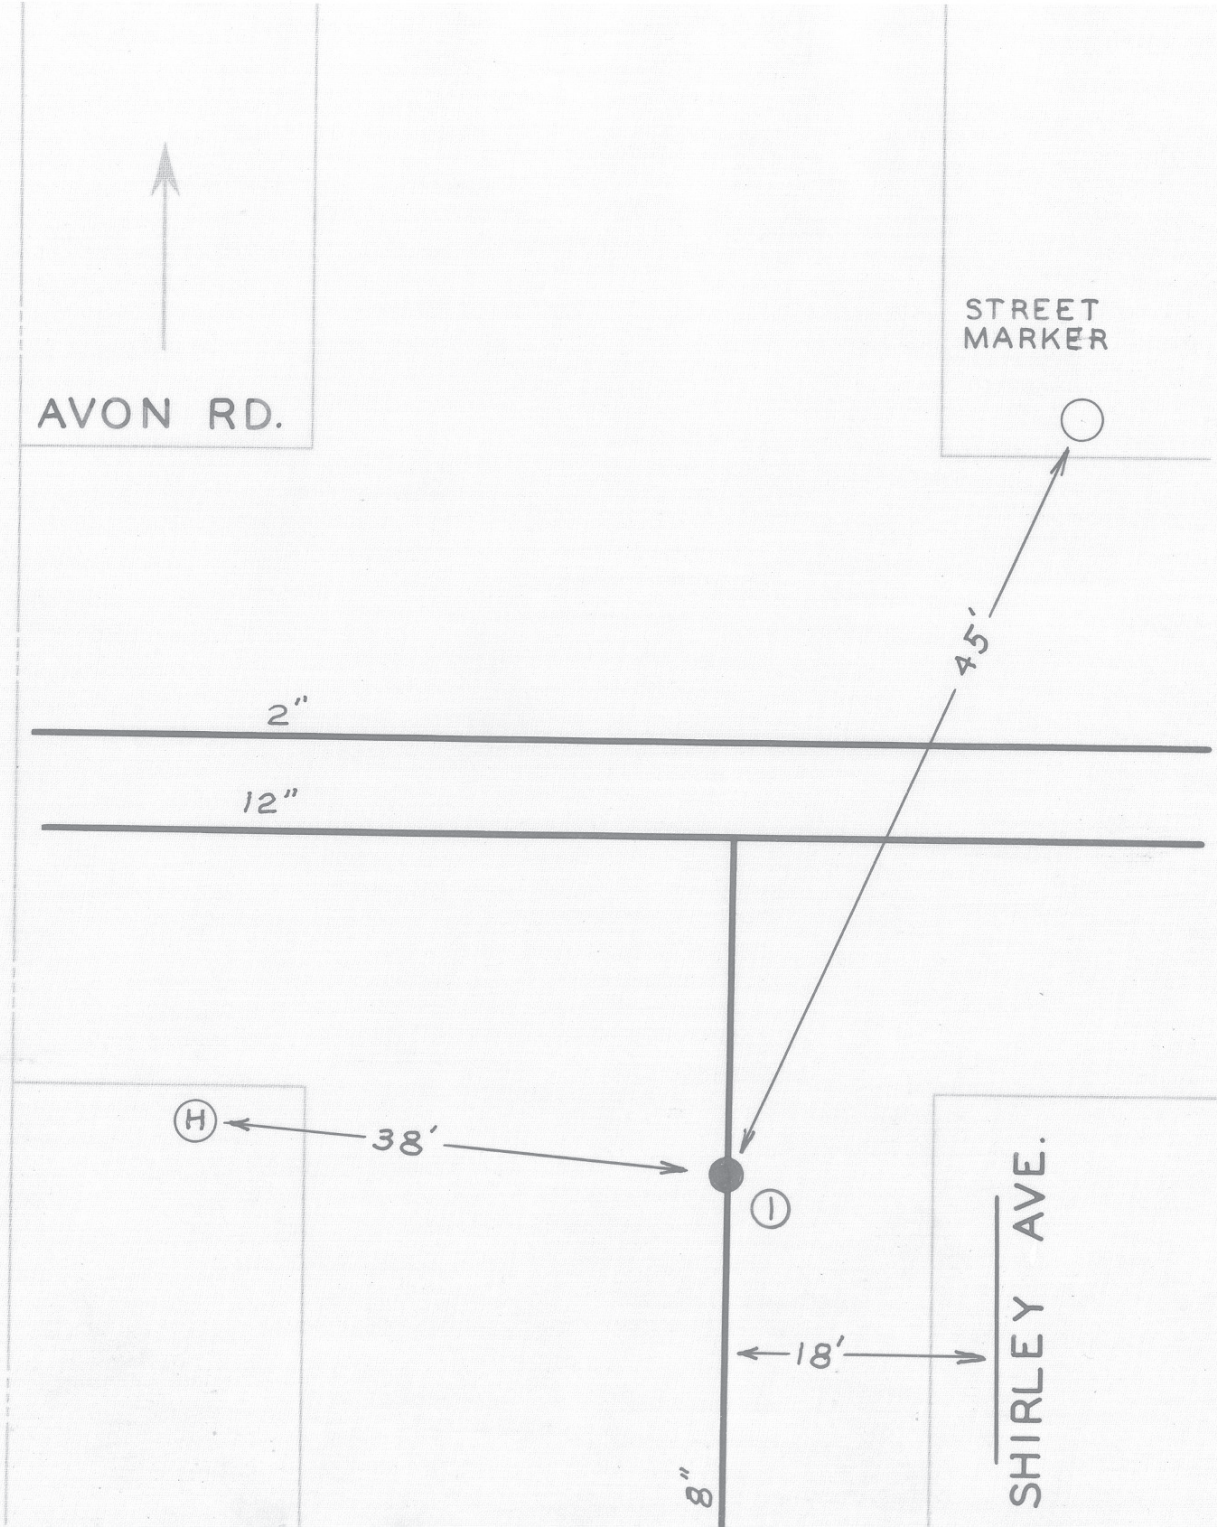

DATE	NO.	SIZE	MAKE	OPEN	TURNS
1953	1	8"	MUELLER	R	
	1	0	SPL		

CITY OF ROANOKE—WATER DEP'T

VALVE DIAGRAM

AVON ROAD & SHIRLEY AVENUE S. W.

SEC. MAP 144

DATE PAGE NO.