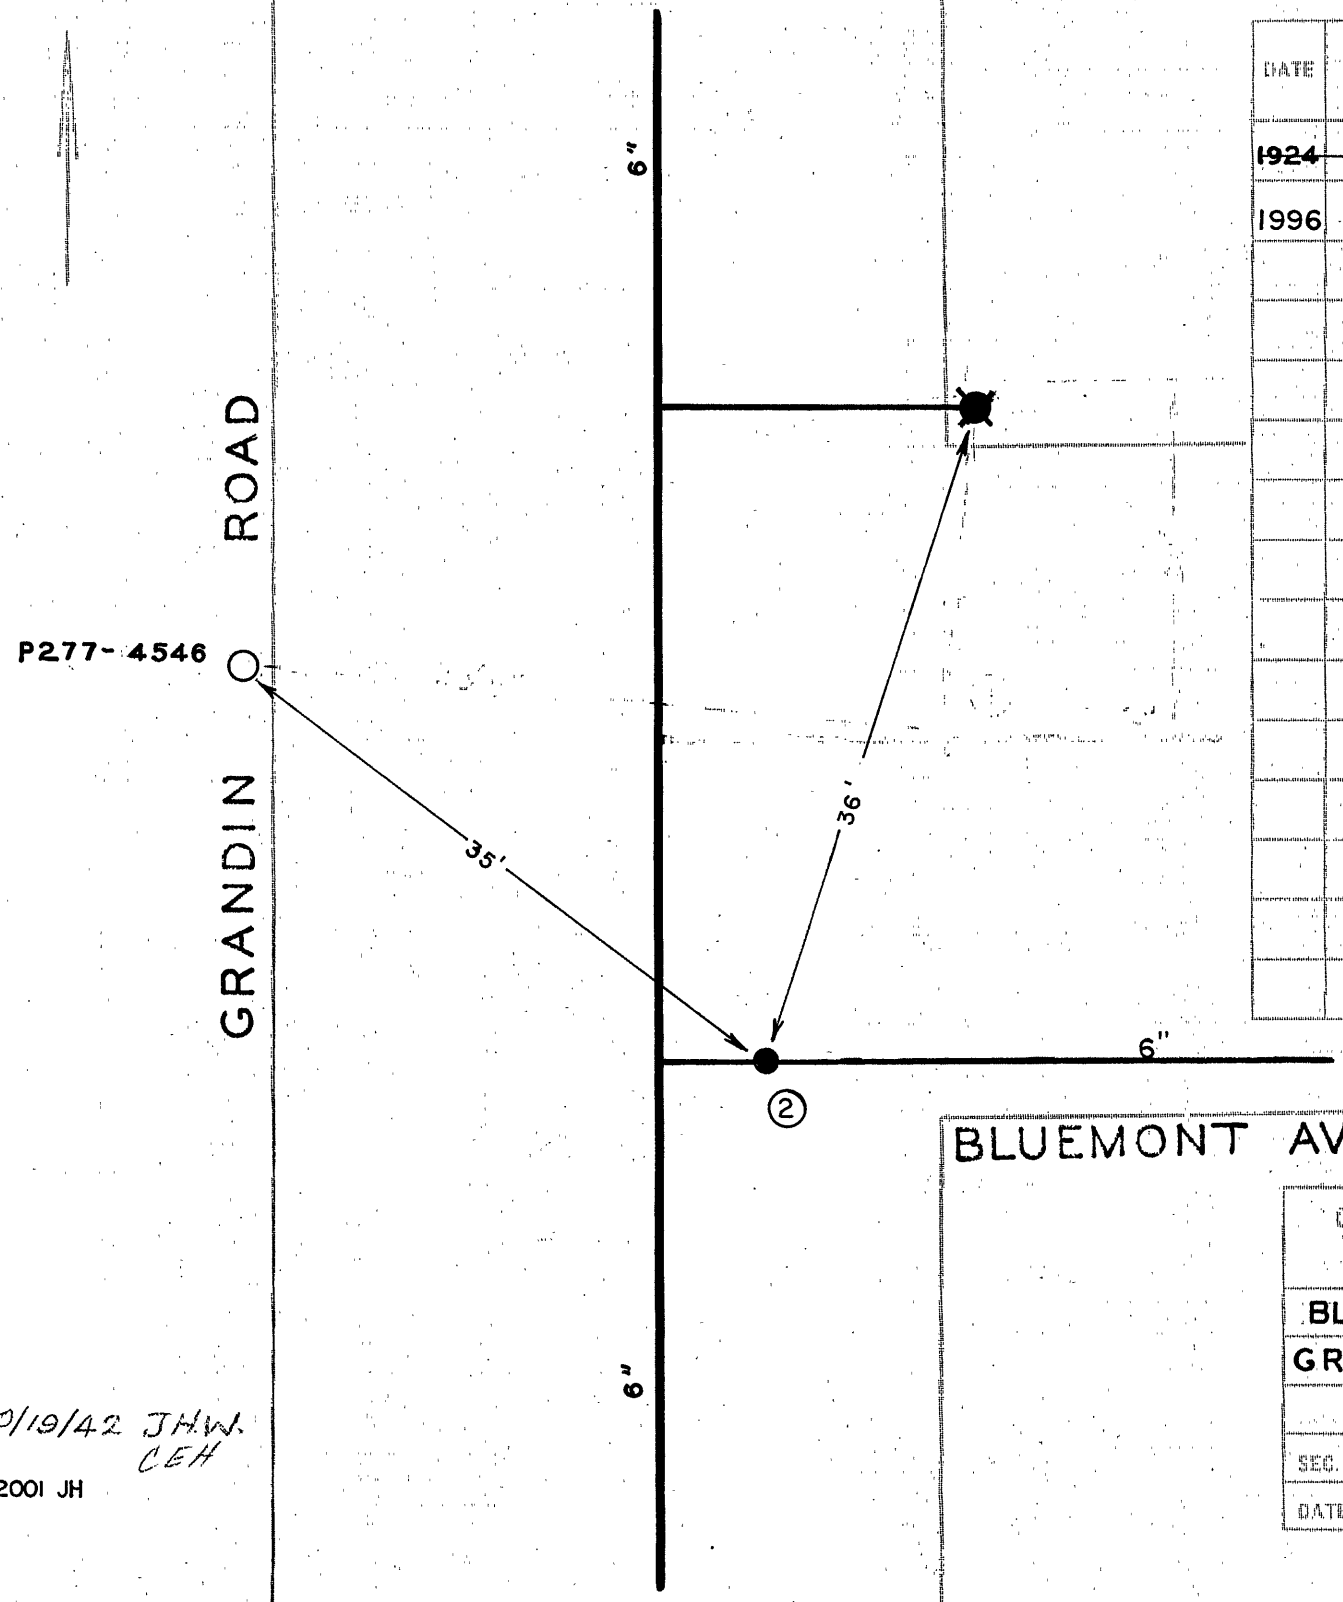

DATE	NO.	SIZE	MAKE	OPEN	TURNS
~~1924~~	~~1~~	~~2"~~		~~R~~	~~7~~
1996	2	6"	MUELLER	R	21
	1	13'-W	EPL		

CITY OF ROANOKE—WATER DEP'T
VALVE DIAGRAM
BLUEMONT AVENUE &
GRANDIN ROAD

SEC. MAP 133 S. W.
DATE PAGE NO. S.W.377

10/19/42 JHW.
CEH

3/2001 JH