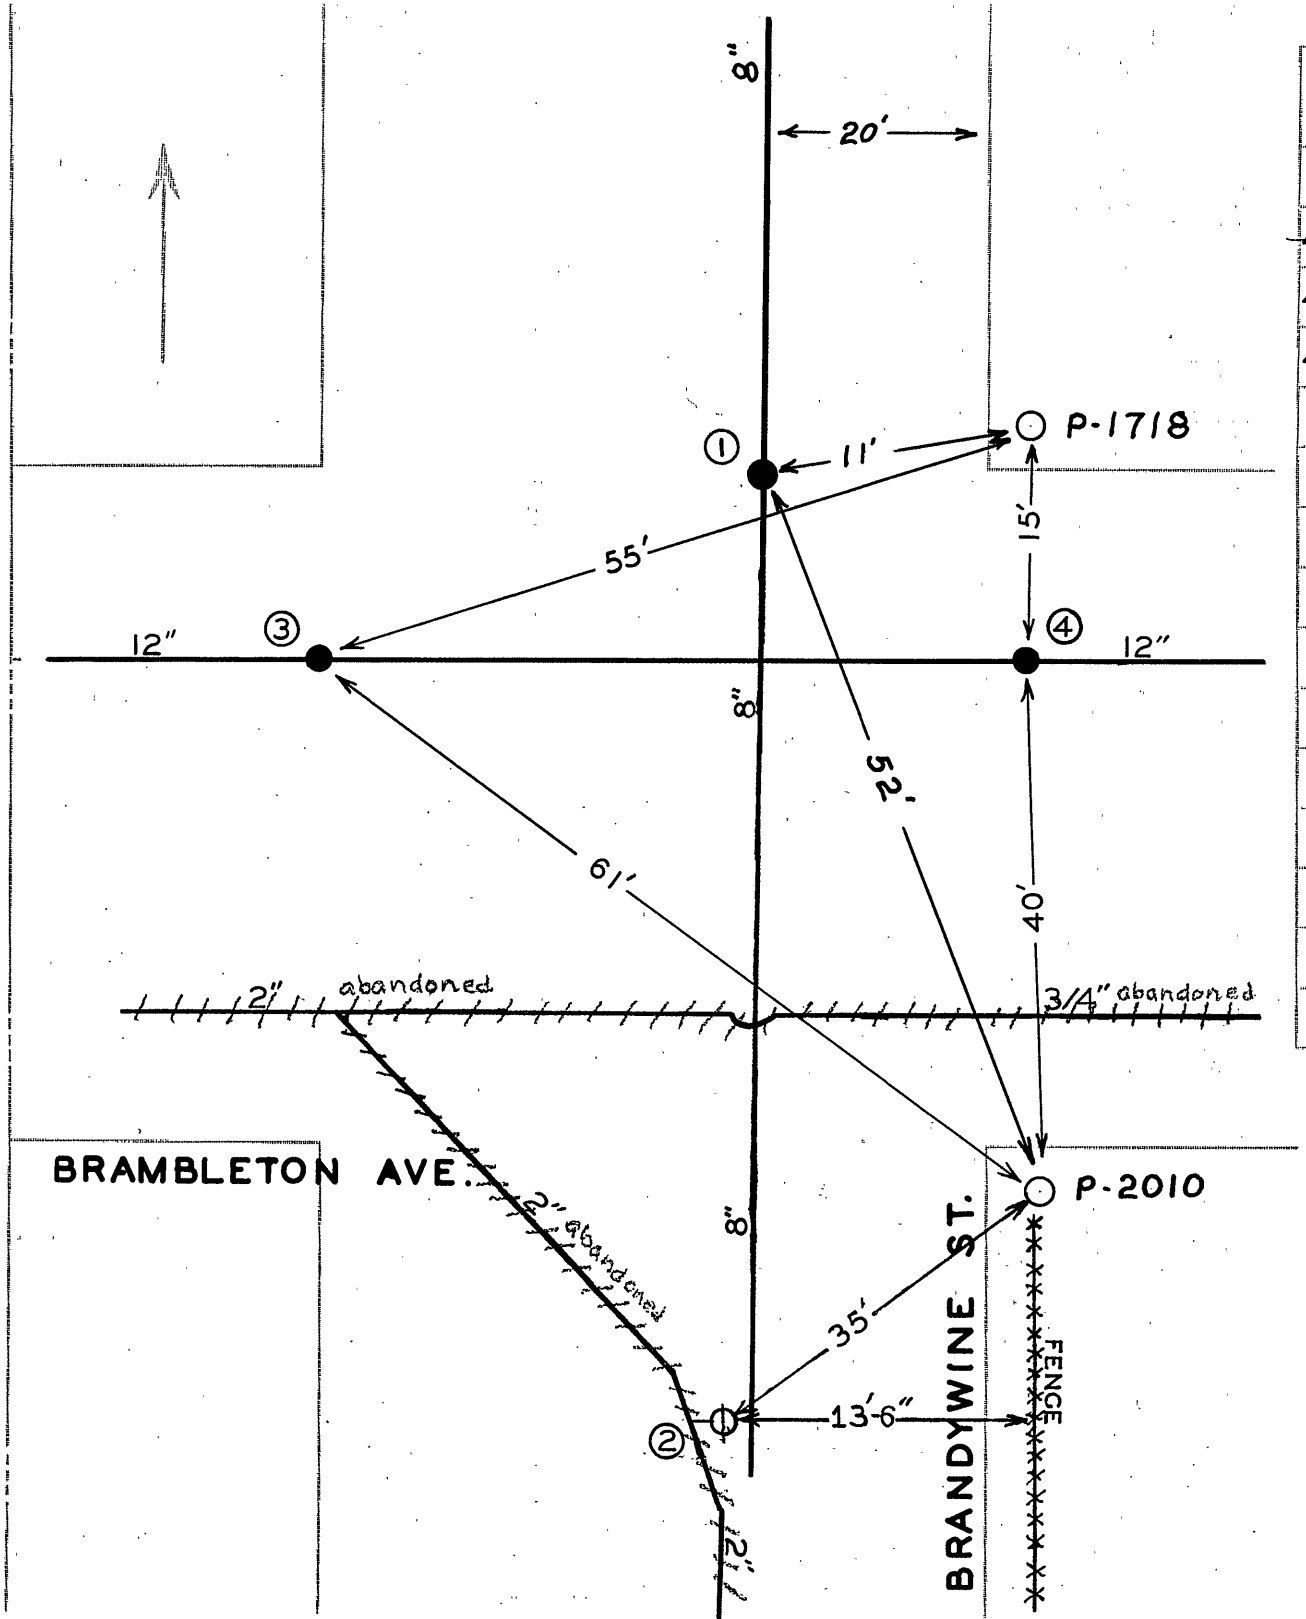

DATE	NO.	SIZE	MAKE	OPEN	TURNS
2-55	1	8"	MUELLER	R	27
~~4-68~~	~~2~~	~~2"~~	~~DARLING~~	~~R~~	
4-69	3	12"	MUELLER	R	
4-69	4	12"	MUELLER	R	
	1	0	NPL		
	2	21"	SPL		

CITY OF ROANOKE — WATER DEP'T

VALVE DIAGRAM

BRAMBLETON AVE. &

BRANDYWINE ST. S.W.

SEC. MAP 165-A

DATE PAGE NO.