DATE	NO.	SIZE	MAKE	OPEN	TURNS
1941	1	2"		R	7
1941	2	2"		R	7
1941	3	2"		R	7
1941	4	2		R	7
1941	5	MANHOLE TO PUMP			
1949	6	8"	DARLING	R	27
1949	7	8"	DARLING	R	27
1951	8	2"	DARLING	R	7

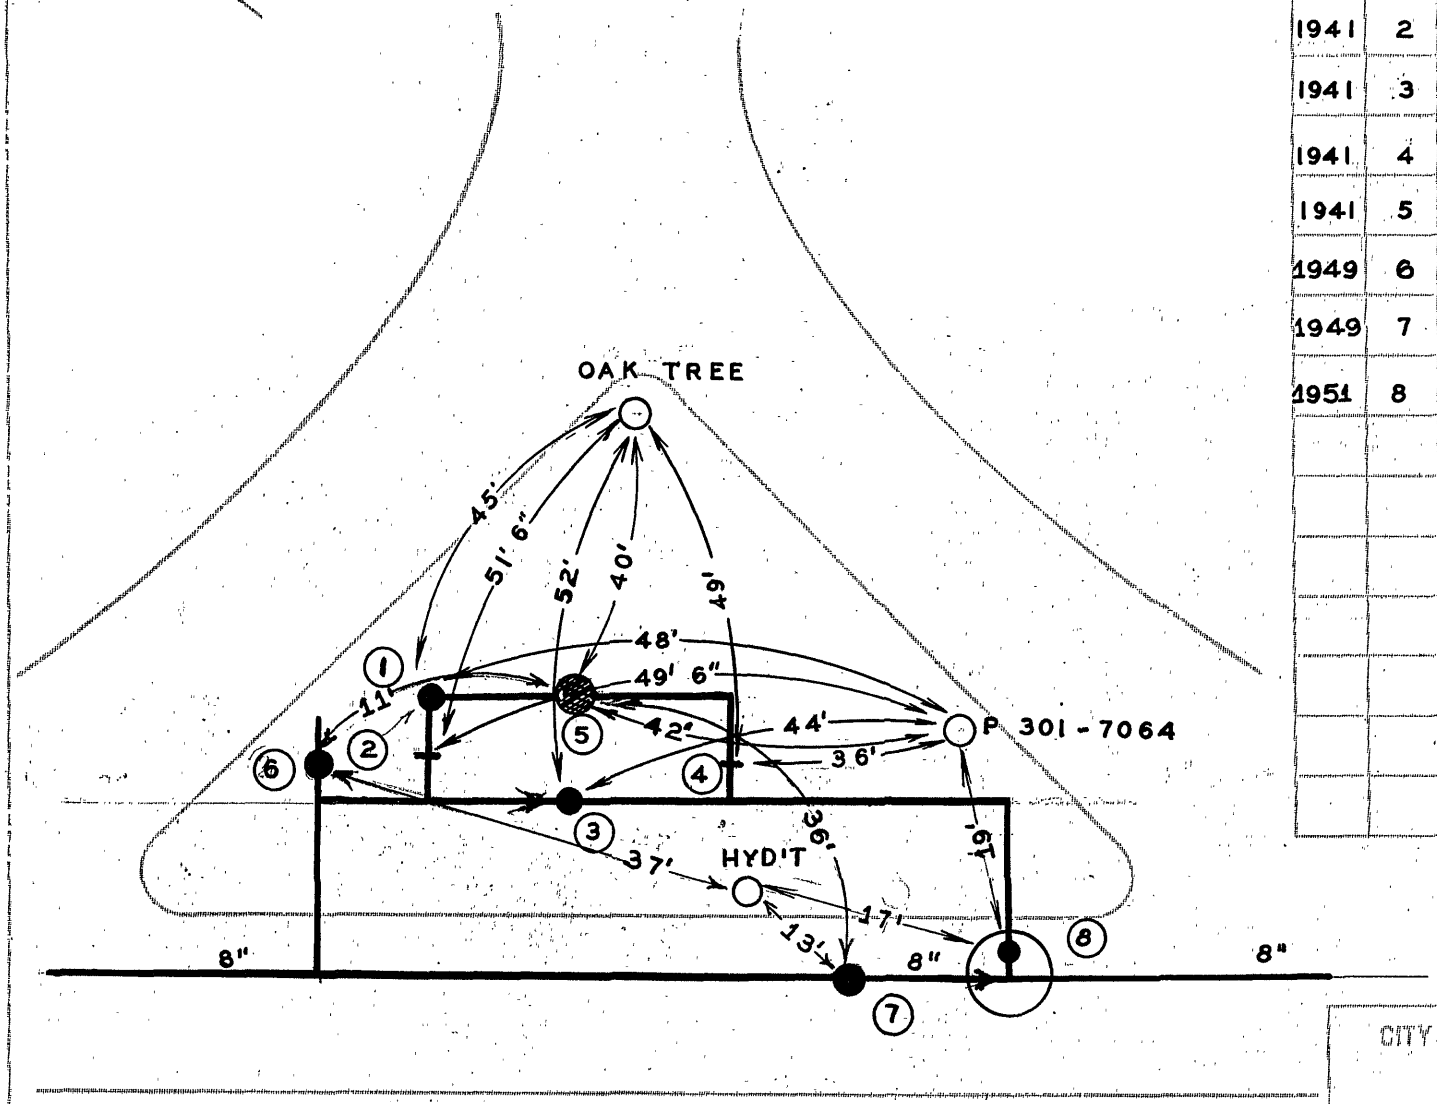

10/6/42 J.H.W.
12/29/42 CEH

CITY OF ROANOKE—WATER DEPT
VALVE DIAGRAM
CHESTNUT HILLS
BOOSTER, STATION.
S.W.
SEC. MAP 108
DATE PAGE NO. S.W. 256